

STATE OF KANSAS
STATE CORPORATION COMMISSION


15-065-00832-00-00

WELL PLUGGING RECORD

Give All Information Completely
Make Required Affidavit
Mail or Deliver Report to:
Conservation Division
State Corporation Commission
800 Biting Building
Wichita, Kansas

Graham County, Sec. 23 Twp. 7S Rge. 22 (X) W (W)

Location as "NE/CNW*SW*" or footage from lines. SW/4 SE/4 NE/4
Lease Owner Osage Oil & Gas Co.
Lease Name WORCESTER Well No. 1
Office Address 531 Petroleum Building, Wichita, Kansas
Character of Well (completed as Oil, Gas or Dry Hole) Dry Hole
Date well completed 3-23-1956
Application for plugging filed 3-23-1956
Application for plugging approved 3-23-1956
Plugging commenced 3-23-1956
Plugging completed 3-23-1956
Reason for abandonment of well or producing formation Dry and abandoned

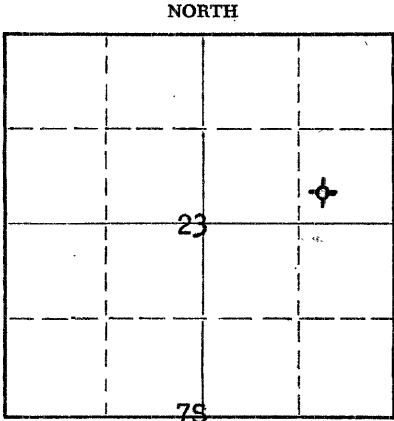

Locate well correctly on above Section Plat

If a producing well is abandoned, date of last production ----- 19
Was permission obtained from the Conservation Division or its agents before plugging was commenced? yes

Name of Conservation Agent who supervised plugging of this well Eldon Petty, Box 326, Hays, Kansas
Producing formation ----- Depth to top --- Bottom -- Total Depth of Well 3800 Feet
Show depth and thickness of all water, oil and gas formations.

OIL, GAS OR WATER RECORDS

CASING RECORD

FORMATION	CONTENT	FROM	TO	SIZE	PUT IN	PULLED OUT
-----	----	---	---	8-5/8" used csg.		
				set at 158.52'		
				cemented w/150 sx.		
				cement, 2 Calcium Chloride.		

Describe in detail the manner in which the well was plugged, indicating where the mud fluid was placed and the method or methods used in introducing it into the hole. If cement or other plugs were used, state the character of same and depth placed, from ----- feet to ----- feet for each plug set.

Stirred pits. Filled hole with heavy mud, 1/2 sack hulls and 15 sacks cement to 148'. Set plug 40' with 1/2 sack hulls and 10 sacks cement.

(If additional description is necessary, use BACK of this sheet)

Name of Plugging Contractor Heathman-Seeligson Drilling Co.
Address 1015 E. Second, Wichita, Kansas


STATE OF Kansas, COUNTY OF Sedgwick, ss.
H. D. Shreve (employee of owner) or ~~owner or operator~~ of the above-described well, being first duly sworn on oath, says: That I have knowledge of the facts, statements, and matters herein contained and the log of the above-described well as filed and that the same are true and correct. So help me God.

(Signature) *[Signature]*
1015 E. Second, Wichita, Kansas
(Address)

SUBSCRIBED AND SWORN to before me this 27 day of March, 1956

[Signature]
Notary Public.

My commission expires June 28, 1956

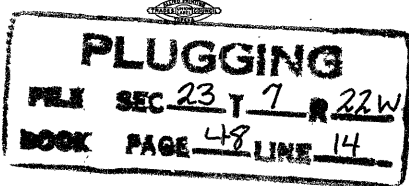

APR 5 1956
CONSERVATION DIVISION
Wichita, Kansas