

15-065-00755-00-01


STATE OF KANSAS
STATE CORPORATION COMMISSION

Form CP-4

Give All Information Completely
Make Required Affidavit
Mail or Deliver Report to:
Conservation Division
State Corporation Commission
212 No. Market
Wichita, Kansas

WELL PLUGGING RECORD

NORTH

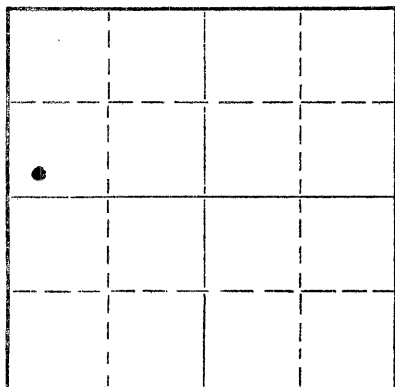

Locate well correctly on above
Section Plat

Graham County. Sec. 23 Twp. 7 Rge. (E) 22 (W)

Location as "NE/CNW/SW" or footage from lines SW-SW-NW
Lease Owner Delbert Worcester
Lease Name Delbert Worcester Well No. 4
Office Address Hill City, Kansas 67642
Character of Well (completed as Oil, Gas or Dry Hole) dry hole
Date well completed November 2 19 72
Application for plugging filed November 2 19 72
Application for plugging approved November 2 19 72
Plugging commenced November 3 11:00 A.M. 19 72
Plugging completed November 3 12:15 P.M. 19 72
Reason for abandonment of well or producing formation unable to washout

If a producing well is abandoned, date of last production 19
Was permission obtained from the Conservation Division or its agents before plugging was commenced? Yes

Name of Conservation Agent who supervised plugging of this well W.L. Nichols
Producing formation _____ Depth to top _____ Bottom _____ Total Depth of Well 750 Feet
Show depth and thickness of all water, oil and gas formations.

OIL, GAS OR WATER RECORDS

CASING RECORD

FORMATION	CONTENT	FROM	TO	SIZE	PUT IN	PULLED OUT

Describe in detail the manner in which the well was plugged, indicating where the mud fluid was placed and the method or methods used in introducing it into the hole. If cement or other plugs were used, state the character of same and depth placed, from _____ feet to _____ feet for each plug set.

With hole full of drilling mud, displaced 25 sacks of cement through drill pipe at 250 feet. Set a bridge at 30 feet with 1/2 sack of hulls and filled surface pipe to cellar with approximately 10 sacks of cement.

RECEIVED
STATE CORPORATION COMMISSION
NOV 8 1972
CONSERVATION DIVISION
Wichita, Kansas

11-8-72

(If additional description is necessary, use BACK of this sheet)

Name of Plugging Contractor Helberg Oil Company
Address Box 32 Morland, Kansas 67650


STATE OF Kansas, COUNTY OF Graham, ss.
Jerry M. Helberg (employee of owner) or (owner or operator) of the above-described

well, being first duly sworn on oath, says: That I have knowledge of the facts, statements, and matters herein contained and the log of the above-described well as filed and that the same are true and correct. So help me God.

(Signature) Jerry M. Helberg
Morland, Kansas 67650
(Address)

SUBSCRIBED AND SWORN TO before me this 6 day of November, 19 72

My commission expires

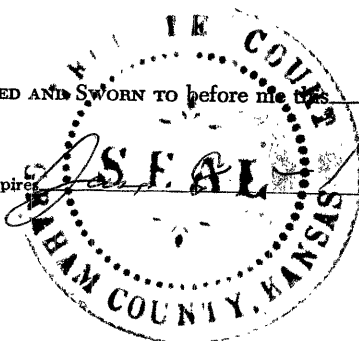

Notary Public