

15-065-06498-00-00


STATE OF KANSAS  
STATE CORPORATION COMMISSION

Give All Information Completely  
Make Required Affidavit  
Mail or Deliver Report to:  
Conservation Division  
State Corporation Commission  
211 No. Broadway  
Wichita, Kansas

WELL PLUGGING RECORD

Graham County. Sec. 28 Twp. 7 Rge. 22 (E) (W)  
Location as "NE/CNW/SW" or footage from lines SE SE NE  
Lease Owner D. G. Hansen  
Lease Name Merlyn Worcester Well No. 1  
Office Address Logan, Kansas  
Character of Well (completed as Oil, Gas or Dry Hole) Dry Hole  
Date well completed June 21 19 58  
Application for plugging filed June 21 19 58  
Application for plugging approved June 21 19 58  
Plugging commenced June 22 19 58  
Plugging completed June 22 19 58  
Reason for abandonment of well or producing formation Too low structurally

NORTH

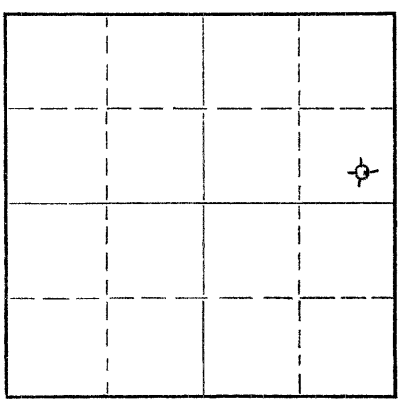

Locate well correctly on above  
Section Plat

If a producing well is abandoned, date of last production \_\_\_\_\_ 19\_\_\_\_  
Was permission obtained from the Conservation Division or its agents before plugging was commenced? Yes

Name of Conservation Agent who supervised plugging of this well Eldon Petty, Hays, Kansas  
Producing formation \_\_\_\_\_ Depth to top \_\_\_\_\_ Bottom \_\_\_\_\_ Total Depth of Well 3860 Feet  
Show depth and thickness of all water, oil and gas formations.

OIL, GAS OR WATER RECORDS				CASING RECORD		
FORMATION	CONTENT	FROM	TO	SIZE	PUT IN	PULLED OUT
				8-5/8"	167.32'	none

Describe in detail the manner in which the well was plugged, indicating where the mud fluid was placed and the method or methods used in introducing it into the hole. If cement or other plugs were used, state the character of same and depth placed, from \_\_\_\_\_ feet to \_\_\_\_\_ feet for each plug set.

Filled hole with heavy mud to 725'.  
Set plug. Put in 25 sacks cement.  
Filled to 160'. Set plug. Put in  
1/2 sack hulls and 15 sacks cement.  
Filled with heavy mud up to 40'.  
Set plug. Filled to top with 1/2  
sack hulls and 10 sacks cement.

JUL 2 1958  
CONSERVATION DIVISION  
Wichita, Kansas

(If additional description is necessary, use BACK of this sheet)  
Name of Plugging Contractor C-G Drilling Co. 7-2-58  
Address 107 Rule Building, Wichita, Kansas

STATE OF KANSAS, COUNTY OF SEDGWICK, ss.  
G. F. Galloway (employee of owner) or (owner or operator) of the above-described well, being first duly sworn on oath, says: That I have knowledge of the facts, statements, and matters herein contained and the log of the above-described well as filed and that the same are true and correct. So help me God.

(Signature) G. F. Galloway  
G. F. Galloway 107 Rule Bldg.  
(Address)

SUBSCRIBED AND SWORN TO before me this 25th day of June, 1958

My commission expires May 20, 1959 Vicky Jacobs Notary Public.

PLUGGING  
FILE SEC 28 T 7 R 22W  
BOOK PAGE 110 LINE 30