

15-065-00106-00-00

WELL PLUGGING RECORD

STATE OF KANSAS
STATE CORPORATION COMMISSION

OR

Strike out upper line
when reporting plug-
ging off formations.


FORMATION PLUGGING RECORD

Graham

County. Sec. 27 Twp. 7 Rge. 22 (E) (W)

Give All Information Completely
Make Required Affidavit
Mail or Deliver Report to:
Conservation Division
State Corporation Commission
800 Biting Building
Wichita, Kansas

NORTH

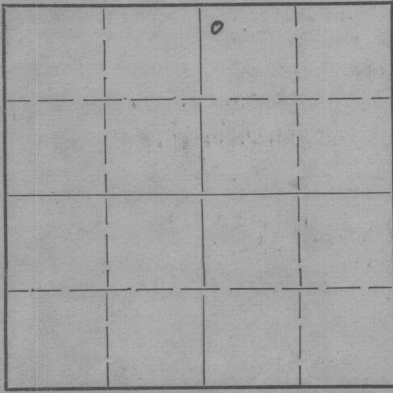

Locate well correctly on above
Section Plat

Location as "NE $\frac{1}{4}$ NW $\frac{1}{4}$ SW $\frac{1}{4}$ " or footage from lines.....
Lease Owner.....
Lease Name..... Logan, Kansas..... Well No. 1
Office Address.....
Character of Well (completed as Oil, Gas or Dry Hole)..... Dry Hole
Date well completed..... May 17- 19 49
Application for plugging filed..... May 15- 19 49
Application for plugging approved..... May 15- 19 49
Plugging commenced..... May 15- 19 49
Plugging completed..... 19
Reason for abandonment of well or producing formation..... Dry Hole

If a producing well is abandoned, date of last production..... 19
Was permission obtained from the Conservation Division or its agents before plugging was com-
menced?..... C. D. Stough, Great Bend, Kansas.

Name of Conservation Agent who supervised plugging of this well.....
Producing formation..... Depth to top..... Bottom..... Total Depth of Well 3775 Feet
Show depth and thickness of all water, oil and gas formations.

OIL, GAS OR WATER RECORDS

CASING RECORD

Formation	Content	From	To	Size	Put In	Pulled Out
Shale		0	160			
Blue Shale		160	226	8 5/8"	201'	None

Describe in detail the manner in which the well was plugged, indicating where the mud fluid was placed and the method or methods used in introducing it into the hole. If cement or other plugs were used, state the character of same and depth placed, from.....feet to
.....feet for each plug set.

Hole filled with heavy mud from 3775' total depth to 200' Permanent plug placed at 200' and cemented with 15 sacks of cement. Heavy mud to the 30' level permanent plug placed at 30' and cemented with 10 sacks of cement to top.

RECEIVED

Conservation-Div.

JUN - 2 1949

STATE CORPORATION
COMMISSION
KANSAS

02-49

(If additional description is necessary, use BACK of this sheet)

Correspondence regarding this well should be addressed to.....
Address..... Logan, Kansas.

STATE OF Barton COUNTY OF Kansas, ss.
Jim Adkins, contractor (employee of owner) or (owner or operator) of the above-described well,
being first duly sworn on oath, says: That I have knowledge of the facts, statements, and matters herein contained and the log of the above-described well as filed and that the same are true and correct. So help me God.

(Signature) Jim Adkins
1502- 12th St., Great Bend, Kansas.

SUBSCRIBED AND SWORN TO before me this 19th day of May, 1949

Pauline B. Adkins
Notary Public.

My commission expires.....

1-26-1952.

