

ORIGINAL

SIDE ONE

CONFIDENTIAL

RELEASED  
MAR 05 1992

3-5-92

STATE CORPORATION COMMISSION OF KANSAS  
OIL & GAS CONSERVATION DIVISION  
RECOMPLETION FORM  
ACO-2 AMENDMENT TO WELL HISTORY

API NO. 15- 065-22 441 -00 01 FROM CONFIDENTIAL

County Graham

55' SW of C SW NE 1 Twp. 7S Rge. 21 X East West

3310 Ft. North from Southeast Corner of Section

1900 Ft. West from Southeast Corner of Section

(NOTE: Locate well in section plat below.)

Lease Name Trexler Well # 4

Field Name Lesage NW

Producing Formation Toronto and L/KC

Elevation: Ground 2141' KB 2146'

Operator: License # 4767

Name: Ritchie Exploration, Inc.

Address: 125 N. Market, Suite 1000

City/State/Zip: Wichita, KS 67202

Purchaser: Koch Oil Company

Operator Contact Person:  
Phone: (316) 267-4375

Designate Type of Original Completion  
 New Well  Re-Entry  Workover

Date of Original Completion 4/11/88

Name of Original Operator Ritchie Exploration, Inc.

Original Well Name Trexler #4


Date of Recompletion:  
11/16/90 11/20/90

Commenced  Completed

Re-entry  Workover

Designate Type of Recompletion/Workover:  
 Oil  SWD  Temp. Abd.  
 Gas  Inj  Delayed Comp.  
 Dry  Other (Core, Water Supply, etc)  
 Deepening  Re-perforation  
 Plug Back  PBTD  
 Conversion to Injection/Disposal

Is recompleted production:  
 Commingled Docket No. \_\_\_\_\_  
 Dual Completion Docket No. \_\_\_\_\_  
 Other (Disposal or Injection?) Docket No. \_\_\_\_\_

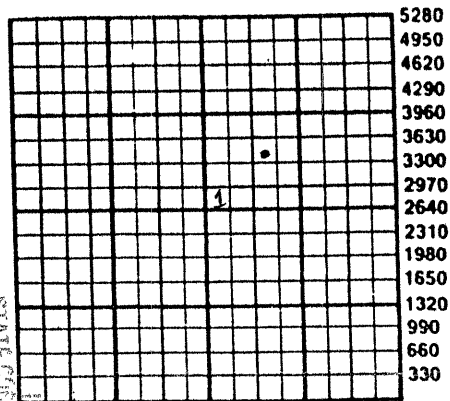

K.C.C. OFFICE USE ONLY  
 Letter of Confidentiality Attached  
 Wireline Log Received  
 Drillers Timelog Received  
Distribution  
 KCC  SWD/Rep  NGPA  
 KGS  Plug  Other (Specify)

CONSERVATION DIVISION  
Wichita, Kansas

FEB 19 1991  
2-19-a-1

INSTRUCTIONS: This form shall be completed in triplicate and filed with the Kansas Corporation Commission, 200 Colorado Derby Building, Wichita, Kansas 67202, within 120 days of the recompletion of any well. Rules 82-3-107 and 82-3-141 apply. Information on side two of this form will be held confidential for a period of 12 months if requested in writing and submitted with the form. See rule 82-3-107 for confidentiality in excess of 12 months. One copy of any additional wireline logs and driller's time logs (not previously submitted) shall be attached with this form. Submit ACO-4 or ACO-5 prior to or with this form for approval of commingling or dual completions. Submit CP-1 with all plugged wells. Submit CP-111 with all temporarily abandoned wells. NOTE: Conversion of wells to either disposal or injection must receive approval before use, submit form U-1.

All requirements of the statutes, rules and regulations promulgated to regulate the oil and gas industry have been fully complied with and the statements herein are complete and correct to the best of my knowledge.

Signature: [Signature] Title President Date 2/18/91

Subscribed and sworn to before me this 18th day of February 19 91

Notary Public Danna Mckaig Date Commission Expires 9/20/94

DANNA MCKAIG  
NOTARY PUBLIC  
STATE OF KANSAS  
My Appl. Exp. 9/20/94

CONFIDENTIAL

SIDE TWO

Operator Name Ritchie Exploration, Inc. Lease Name Trexler Well # 4

Sec. 1 Twp. 7S Rge. 21  
 East  
 West

County Graham

RECOMPLETION FORMATION DESCRIPTION

Log  Sample

Name	Top	Bottom
Toronto	3364'	3374'

ADDITIONAL CEMENTING/SQUEEZE RECORD					
Purpose: <input type="checkbox"/> Perforate <input type="checkbox"/> Protect Casing <input type="checkbox"/> Plug Back TD <input type="checkbox"/> Plug Off Zone	Depth		Type of Cement	# Sacks Used	Type and Percent Additives
	Top	Bottom			

Shots Per Foot	PERFORATION RECORD Specify Footage of Each Interval Perforated		Acid, Fracture, Shot, Cement Squeeze Record (Amount and Kind of Material Used)
3	3364'	67'	750 gals 15%

PBTD \_\_\_\_\_ Plug Type \_\_\_\_\_

TUBING RECORD

Size 2 3/8" Set At 3646' Packer At \_\_\_\_\_ Was Liner Run \_\_\_\_\_ Y \_\_\_\_\_ N

Date of Resumed Production, Disposal or Injection 11/20/90

Estimated Production Per 24 Hours Oil 6.2 Bbls. Water 35 Bbls. \_\_\_\_\_ Gas-Oil-Ratio  
Gas \_\_\_\_\_ Mcf

Disposition of Gas:

Vented  Sold  Used on Lease (If vented, submit ACO-18.)