

00-00

STATE CORPORATION COMMISSION OF KANSAS
OIL & GAS CONSERVATION DIVISION
WELL COMPLETION OR RECOMPLETION FORM
ACO-1 WELL HISTORY
DESCRIPTION OF WELL AND LEASE

5

API NO. 15-065-22,441
County Graham
80' E & 10' N of
C. SW. NE. Sec. 1 Twp. 7S. Rge. 21W. West

Operator: License # 4767
Name Ritchie Exploration, Inc.
Address 125 N. Market, Suite 1000
Wichita, KS 67202
City/State/Zip

3310 Ft North from Southeast Corner of Section
1900 Ft West from Southeast Corner of Section
(Note: Locate well in section plat below)

Purchaser Koch Oil Company
Wichita, KS

Lease Name Trexler Well # 4

Operator Contact Person Jeff Christian
Phone 316-267-4375

Field Name Le Sage, NW

Producing Formation Lansing


Contractor License # 6033
Name Murfin Drilling Company

Elevation: Ground 2141' KB 2146'

Wellsite Geologist Bob Mathiesen
Phone 316-267-4375

PLEASE KEEP THIS
INFORMATION
CONFIDENTIAL

Section Plat

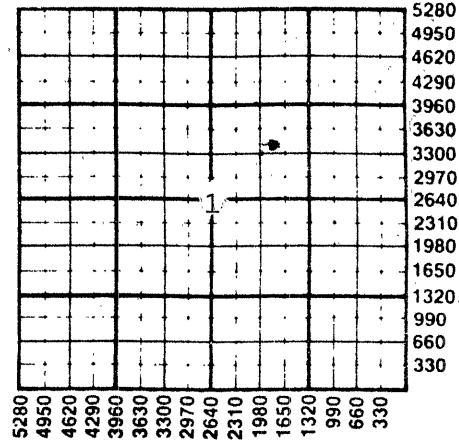

Designate Type of Completion
 New Well Re-Entry Workover

Oil SWD Temp Abd
 Gas Inj Delayed Comp.
 Dry Other (Core, Water Supply etc.)

If OWNO: old well info as follows:

Operator
Well Name
Old Total Depth

WELL HISTORY

Drilling Method:
 Mud Rotary Air Rotary Cable

3-7-88 3-15-88 4/11/88
Spud Date Date Reached TD Completion Date

3650' n/a
Total Depth PBTD 8-5/8" @ 217'

Amount of Surface Pipe Set and Cemented at...feet
Multiple Stage Cementing Collar Used? Yes No
If yes, show depth set...1750' feet
If alternate 2 completion, cement circulated
from...1750' feet depth to surface 475' cmt
Cement Company Name Allied Cementing Co.
Invoice # 51170 7-11-88

WATER SUPPLY INFORMATION
Disposition of Produced Water: Disposal
Docket # D25,274 Repressuring

Questions on this portion of the ACO-1 call:
Water Resources Board (913) 296-3717

Source of Water: Hauled.
Division of Water Resources Permit #

Groundwater...Ft North from Southeast Corner
(Well) ...Ft West from Southeast Corner of
Sec Twp Rge East West

Surface Water...Ft North from Southeast Corner
(Stream, pond etc)...Ft West from Southeast Corner
Sec Twp Rge East West

Other (explain) (purchased from city, R.W.D. #)

INSTRUCTIONS: This form shall be completed in triplicate and filed with the Kansas Corporation Commission, 200 Colorado Derby Building, Wichita, Kansas 67202, within 120 days of the spud date of any well. Rule 82-3-130, 82-3-107 and 82-3-106 apply. Information on side two of this form will be held confidential for a period of 12 months if requested in writing and submitted with the form. See rule 82-3-107 for confidentiality in excess of 12 months. One copy of all wireline logs and drillers time log shall be attached with this form. Submit CP-4 form with all plugged wells. Submit CP-111 form with all temporarily abandoned wells.

All requirements of the statutes, rules and regulations promulgated to regulate the oil and gas industry have been fully complied with and the statements herein are complete and correct to the best of my knowledge.

Signature [Signature]
Title Vice President Date 6/30/88

Subscribed and sworn to before me this 30th day of June 1988.
Notary Public Linda K. Rice

Date Commission Expires 6/07/92

K.C.C. OFFICE USE ONLY
 Letter of Confidentiality Attached
 Wireline Log Received
 Drillers Timelog Received
Distribution
 KCC SWD/Rep NGPA
 KGS Plug Other
(Specify)
1988 7-1-88
Form ACO-1 (5-86)



RECEIVED
STATE CORPORATION COMMISSION
Wichita, Kansas

Sec. 1, Twp. 7, Rge. 21W