


STATE OF KANSAS  
STATE CORPORATION COMMISSION

Give All Information Completely  
Make Required Affidavit  
Mail or Deliver Report to:  
Conservation Division  
State Corporation Commission  
800 Biting Building  
Wichita, Kansas

15-065-00222-00-00

WELL PLUGGING RECORD

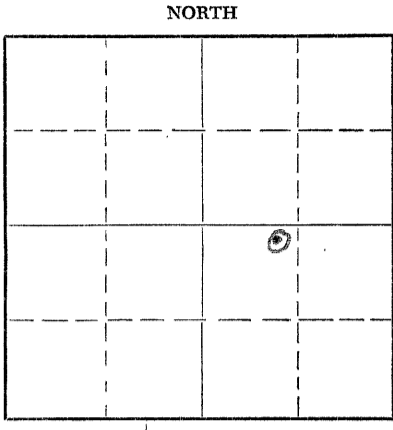

Locate well correctly on above Section Plat

Graham County, Sec. 5 Twp. 7 Rge. 21 (E) (W)  
Location as "NE/CNW/SW" or footage from lines Ne-Nw-Se  
Lease Owner Keating Drlg. Co.  
Lease Name Minnie McKisson Well No. 1  
Office Address Natl. Bank Of Tulsa Bldg. Tulsa Oklahoma  
Character of Well (completed as Oil, Gas or Dry Hole) Dry Hole  
Date well completed 9-9-52 19  
Application for plugging filed 9-9-52 19  
Application for plugging approved 9-9-52 19  
Plugging commenced 9-9-52 19  
Plugging completed 9-9-52 19  
Reason for abandonment of well or producing formation Dry Hole

If a producing well is abandoned, date of last production \_\_\_\_\_ 19  
Was permission obtained from the Conservation Division or its agents before plugging was commenced? Yes

Name of Conservation Agent who supervised plugging of this well Mr. Eldon Petty  
Producing formation None Depth to top \_\_\_\_\_ Bottom \_\_\_\_\_ Total Depth of Well 3740 Feet  
Show depth and thickness of all water, oil and gas formations.

OIL, GAS OR WATER RECORDS

CASING RECORD

FORMATION	CONTENT	FROM	TO	SIZE	PUT IN	PULLED OUT
	190-	Top	190	8 5/8	190	None

Describe in detail the manner in which the well was plugged, indicating where the mud fluid was placed and the method or methods used in introducing it into the hole. If cement or other plugs were used, state the character of same and depth placed, from \_\_\_\_\_ feet to \_\_\_\_\_ feet for each plug set.

15 Filled hole to 180 Ft. with mud pushed plug to 180  
poured 16 sacks cement through drill pipe, Filled hole to 40 ft. with mud  
put 1 sack hulls and 10 sacks cement filled to bottom of cellar

RECEIVED  
STATE CORPORATION COMMISSION  
SEP 15 1952  
CONSERVATION DIVISION  
Wichita, Kansas

Name of Plugging Contractor Plugged by hand and Company tools (If additional description is necessary, use BACK of this sheet)  
Address 510 Natl. Bank Of Tulsa Bldg, Tulsa Oklahoma 9-15-52

STATE OF Kansas, COUNTY OF Graham, ss.  
Hugh Brittan of owner (employee of owner) or ~~owner's operator~~ of the above-described well, being first duly sworn on oath, says: That I have knowledge of the facts, statements, and matters herein contained and the log of the above-described well as filed and that the same are true and correct. So help me God.

(Signature) Hugh Brittan  
Box 585 Hill City Kansas (Address)

SUBSCRIBED AND SWORN TO before me this 13th day of September, 1952

Bryan B. Parker  
Bryan B. Parker Notary Public.

My commission expires March 5, 1956.

24-2675-S 2-52-20M

PLUGGING  
FILE SEC 5-T-2-R21W  
BOOK PAGE 44 LINE 19

PLUGGING  
FILE SEC 5-T-2-R21W  
BOOK PAGE 44 LINE 19

15-065-00222-00-00

Company: A.F. Keating (510 Natl. Bank of Tulsa Bldg, Tulsa 3, Okla. or 836 Marcilehe, Wichita 17, Kans).

Farm : Minnie McKisson Well No. 1 Loc. NE NW SE 5-7-21W

TD : 3740' County: Graham, Ks.

Comm: 8/30/52 Comp. 3/9/52 Prod. D & A

Tools: Keating Drlg. Co. Elev. 2177 KB

Csg : 193' of 8 5/8" set at 196' Time Log: Geolograph

Elec. Log Schlumberger

0- 65 surface clay & sand  
65- 220 sand, clay, shale  
220- 950 shale & shells  
950-1560 shale & sand  
1560-1800 shale & sand  
1800-1825 anhydrite  
1825-1897 anhyd. & shale  
1897-2350 shale  
2350-2380 limy shale  
2380-2860 lime & shale  
2860-2950 shale & lime  
2950-3150 lime & shale  
3150-3186 shale & lime  
3186-3244 Topeka lime  
3244-3338 lime  
3338-3349 shale  
3349-3473 shale & lime  
3473-3740 lime and shale  
3740 TD

Geol. Tops (Schl).

Anhydrite 1800  
Topeka 3186  
Heebner 3394  
Toronto 3415  
L-KC 3430  
B/KC 3625  
Cong. (none)  
Arbuckle 3687  
TD (in Arb) 3740

DST's

DST #1 3454-73, 1 hr. rec.  
30' drlg. mud, no wtr, pin-  
points oil, steady, strong  
blow 1 hr. Shut-in 20 min.  
BHP 1150#, Ini. Flow 50#,  
Final Flow 200#.

3462-70 fair por (pinpoint), odor  
in spls, stain oil  
3495-00 poor por., sl. spotted  
oil stains, watery appear.  
3687-3725 good to fair porosity,  
gilsonite, no live oil.

668

STATE OF Kansas COUNTY OF Sedgwick SS:

Dale Martin, representative of operator of above described well, being first duly sworn on oath, states: That I have knowledge of the facts, statements and matters herein contained, and the log of the above well as filed, and the same are true and correct. So help me God.

Signature

Dale Martin  
836 Marcilehe, Wichita 17, Ks

Subscribed and sworn to before me, this 16th day of September, 1952.

My commission expires October 17, 1953 Dorothy M. Barber

RECEIVED  
STATE CORPORATION COMMISSION Notary Public

SEP 18 1952

CONSERVATION DIVISION  
Wichita, Kansas

9-18-52

