

STATE OF KANSAS
STATE CORPORATION COMMISSION

15-065-00221-00-00

WELL PLUGGING RECORD

Give All Information Completely
Make Required Affidavit
Mail or Deliver Report to:
Conservation Division
State Corporation Commission
800 Bittling Building
Wichita, Kansas

Graham County. Sec. 6 Twp. 7 Rge. 21 (E) W. (W)

Location as "NE/CNW $\frac{1}{4}$ SW $\frac{1}{4}$ " or footage from lines SW SW SW

Lease Owner A. F. Keating

Lease Name Ridgley Well No. 1

Office Address 510 Natl. Bank of Tulsa Bldg. Tulsa 3, Okla.

Character of Well (completed as Oil, Gas or Dry Hole) Dry Hole

Date well completed Jan. 13 19 52

Application for plugging filed Jan. 15 19 52

Application for plugging approved Jan. 15 19 52


Plugging commenced 19

Plugging completed 19

Reason for abandonment of well or producing formation Oil not found in commercial quantities

If a producing well is abandoned, date of last production 19

Was permission obtained from the Conservation Division or its agents before plugging was commenced? Yes

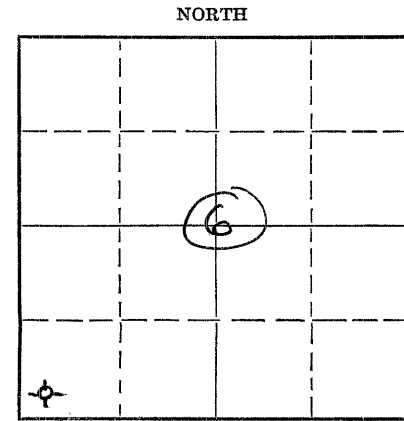

Locate well correctly on above Section Plat

Name of Conservation Agent who supervised plugging of this well Eldon Petty - Hayes, Kansas.

Producing formation None Depth to top Bottom Total Depth of Well 3810 Feet

Show depth and thickness of all water, oil and gas formations.

OIL, GAS OR WATER RECORDS

CASING RECORD

Formation	Content	From	To	Size	Put In	Pulled Out
Surface		0	280'	8-5/8" (28#)	280'	None
Surface to Arb.		0	3753'	5-1/2" (14#)	3753'	
Arbuckle	dry	3751	3756'			
Arbuckle	asphaltic oil	3756	3758			
Arbuckle	dry	3758	3798			
Arbuckle	water	3798	3810			
Marm. Sd.	very heavy oil	3725	3729			
L-KC	oil & Wtr.	3664	3688			

Describe in detail the manner in which the well was plugged, indicating where the mud fluid was placed and the method or methods used in introducing it into the hole. If cement or other plugs were used, state the character of same and depth placed, from feet to feet for each plug set.

Rotary T.D. was 3758' (in Arbuckle). Set 3753' 5 1/2" (14#) csg. Sun Co. cement w/ 75 sx. back to 3550'. Drilled ahead with cable tools to 3810'. Ran 2" tubing and Baker retainer to 3748. Set retainer and squeezed off open hole with 75 sx. cement (Sun Oil Well Cementing Co.) Perf. Marmaton sand zone 3725-29' with 16 shots (solid). Heavy oil - no water. Set Lane Wells plug at 3685 (top) Perf. L-KC 3651-56 and 3664-68 with 36 cone shots. Acidized 2000 gal. acid recovered oil and water. Believed plug may have been damaged by cable tools, ran second Lane Wells plug to 3681'. Treated 4000 gals. acid. Went to water. Requested permit to plug well. Permit granted. Pulled 1000 ft. 5 1/2" csg. Ran river gravel to 3638', dumped 4 sx. cement from 3638' to 3628'. Mudded hole, set rock bridge at 270' depth in 8-5/8" surface string, and mudded hole, ran 15 sx. cement in surface string to base of cellar.

(If additional description is necessary, use BACK of this sheet)

Name of Plugging Contractor W. R. Mullin
Address 216 W. Washington, Lyons, Kansas.

STATE OF Kansas COUNTY OF Sedgwick, ss.
Dale Martin, representative (Employer of owner) (Operator of well)

being first duly sworn on oath, says: That I have knowledge of the facts, statements, and matters herein contained and the log of the above-described well as filed and that the same are true and correct. So help me God.

(Signature) Dale Martin

836 Marcilene, Wichita 17, Kans.
(Address) (Ph. 6-1074)

SUBSCRIBED AND SWORN to before me this 6th day of March, 1952.

My commission expires October 17, 1953 Dorothy M. Barber Notary Public.

23-8390-s 6-51-20M
PLUGGING
FILE SEC 6T-7-R-244
BOOK PAGE 134 LINE 4

3-8-52