

CARD MUST BE TYPED

State of Kansas

CARD MUST BE SIGNED

NOTICE OF INTENTION TO DRILL

*CORRECTED

(see rules on reverse side)

Expected Spud Date. 3/07/88 month day year

API Number 15-065-22,441-00-000

*80' E & 10' N of

OPERATOR: License # 4767

C SW NE Sec. 1 Twp. 7 S, Rg. 21 XX East West

* 3310 Ft. from South Line of Section

* 1900 Ft. from East Line of Section

Name Ritchie Exploration, Inc.

Address 125 N. Market, Suite 1000

City/State/Zip Wichita, KS 67202

Contact Person Jeff Christian

Phone 316/267-4375

CONTRACTOR: License # 6033

Name Murfin Drilling Co.

City/State Wichita, KS

Well Drilled For: Well Class: Type Equipment:

X Oil Storage Infield X Mud Rotary

Gas Inj Pool Ext Air Rotary

OWWO Expl Wildcat Cable

If OWWO: old well info as follows:

Operator

Well Name

Comp Date Old Total Depth

I certify that well will comply with K.S.A. 55-101, et seq., plus eventually plugging hole to KCC specifications.

Date 3/07/88 Signature of Operator or Agent Jeff Christian Title Geologist

For KCC Use:

Conductor Pipe Required feet; Minimum Surface Pipe Required 200 feet per Alt. X (2)

This Authorization Expires 8-26-88 Approved By RCH 3-23-88

*WAS: 55' SW of 3261' FSL NLL 621 *CORRECTED LOCATION ORIG RW 10 2-26-88


C-SW-NE 2019' FEL API# 15-065-22,441

Must be filed with the K.C.C. five (5) days prior to commencing well
 This card void if drilling not started within six (6) months of date received by K.C.C.

Important procedures to follow:

1. Notify District office before setting surface casing.
2. Set surface casing by circulating cement to the top.
3. File completion forms ACO-1 with K.C.C. within 120 days of well spud date, following instructions on ACO-1, side 1, and including copies of wireline logs.
4. Notify District office 48 hours prior to old well workover or re-entry.
5. Prior to filing Intent, prepare a proposed plugging plan in case well is D & A, then obtain approval of plan when calling district office prior to setting surface pipe.
6. Submit plugging report (CP-4) to K.C.C. after plugging is completed.
7. Obtain an approved injection docket number before disposing of salt water.
8. Notify K.C.C. within 10 days when injection commences or terminates.
9. If an alternate 2 completion, cement in the production pipe from below any usable water to surface within 120 days of spud date.

**A Regular Section of Land
 1 Mile = 5,280 Ft.**

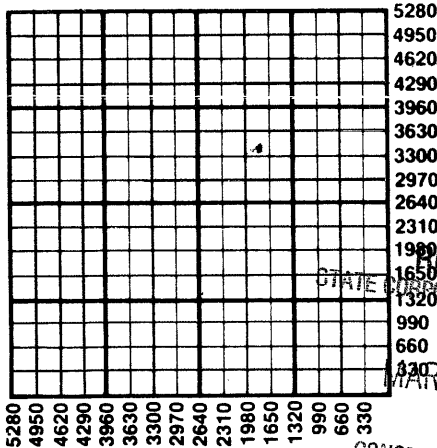

5280
4950
4620
4290
3960
3630
3300
2970
2640
2310
1980
1650
1320
990
660
330

5280
4950
4620
4290
3960
3630
3300
2970
2640
2310
1980
1650
1320
990
660
330

RECEIVED
 STATE CORPORATION COMMISSION

MAR 23 1988

CONSERVATION DIVISION
 Wichita, Kansas

3-23-88

State Corporation Commission of Kansas
 Conservation Division
 200 Colorado Derby Building
 Wichita, Kansas 67202-1212
 (316) 263-3238