

CARD MUST BE TYPED

State of Kansas

CARD MUST BE SIGNED

NOTICE OF INTENTION TO DRILL

(see rules on reverse side)

Starting Date 6 month 10 day 87 year

API Number 15— 065-22,386-0000

OPERATOR: License # 5131
Name Thunderbird Drilling, Inc.
Address P.O. Box 780407
City/State/Zip Wichita, Kansas 67278
Contact Person Bucke Krueger
Phone (316) 685-1441

C W/2 SW NE Sec. 2 Twp. 7 S, Rg. 21 East West
3300
2310
Ft. from South Line of Section
Ft. from East Line of Section

(Note: Locate well on Section Plat on reverse side)

CONTRACTOR: License # 5145
Name Dreiling Oil, Inc.
City/State Victoria, KS

Nearest lease or unit boundary line 330 feet
County Graham
Lease Name HOLSMAN Well # 1

Well Drilled For: Well Class: Type Equipment:
 Oil SWD Infield Mud Rotary
 Gas Inj Pool Ext. Air Rotary
 OWWO Expl Wildcat Cable

Ground surface elevation 2200 feet MSL
Domestic well within 330 feet: ___yes no
Municipal well within one mile: ___yes no
Surface pipe by Alternate: 1 ___ 2 ___
Depth to bottom of fresh water 380
Depth to bottom of usable water 1100
Surface pipe planned to be set 400
Projected Total Depth 3700 feet
Formation Arbuckle

If OWWO: old well info as follows:
Operator
Well Name
Comp Date Old Total Depth

I certify that well will comply with K.S.A. 55-101, et seq., plus eventually plugging hole to KCC specifications.

cementing will be done immediately upon setting production casing.
Date 6/8/87 Signature of Operator or Agent Gloria DeJoux Title Land Mgr

For KCC Use:
Conductor Pipe Required feet; Minimum Surface Pipe Required 400 feet per Alt. 400
This Authorization Expires 12-8-87 Approved By 6-8-87


[Handwritten signatures]

Must be filed with the K.C.C. five (5) days prior to commencing well
 This card void if drilling not started within six (6) months of date received by K.C.C.

Important procedures to follow:

1. Notify District office before setting surface casing.
2. Set surface casing by circulating cement to the top.
3. File completion forms ACO-1 with K.C.C. within 90 days of well completion, following instructions on ACO-1, side 1, and including copies of wireline logs.
4. Notify District office 48 hours prior to old well workover or re-entry.
5. Prior to filing Intent, prepare a proposed plugging plan in case well is D & A, then obtain approval of plan when calling district office prior to setting surface pipe.
6. Submit plugging report (CP-4) to K. C. C. after plugging is completed.
7. Obtain an approved injection docket number before disposing of salt water.
8. Notify K.C.C. within 10 days when injection commences or terminates.
9. If an alternate 2 completion, cement in the production pipe from below any usable water to surface within 120 days of spud date.

A Regular Section of Land
1 Mile = 5,280 Ft.

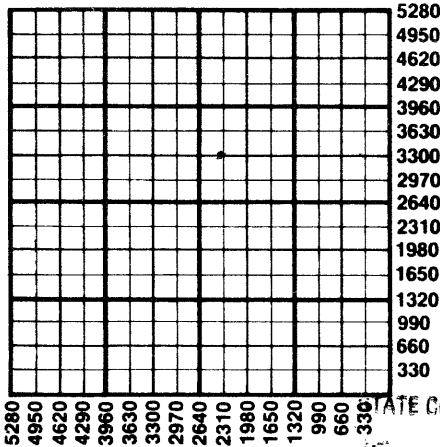

RECEIVED

STATE CORPORATION COMMISSION

JUN 8 1987

Wichita, Kansas

State Corporation Commission of Kansas
 Conservation Division
 200 Colorado Derby Building
 Wichita, Kansas 67202
 (316) 263-3238