

CARD MUST BE TYPED

State of Kansas

CARD MUST BE SIGNED

NOTICE OF INTENTION TO DRILL

(see rules on reverse side)

Expected Spud Date.....4/02/88.....
month day year

API Number 15—065-22,447-00-00³

OPERATOR: License #.....4767.....

NE SE NW Sec.....1 Twp.....7 S, Rg. 21 XX East West

Name.....Ritchie Exploration, Inc......

Address.....125 N. Market, Suite 1000.....

City/State/Zip.....Wichita, KS 67202.....

Contact Person.....Jeff Christian.....

Phone.....316/267-4375.....

3630 Ft. from South Line of Section
2970 Ft. from East Line of Section

(Note: Locate well on Section Plat on reverse side)

CONTRACTOR: License #.....6033.....

Nearest lease or unit boundary line330..... feet
County.....Graham.....

Name.....Murfin Drilling Co......

City/State.....Wichita, KS.....

Lease Name.....Brad Trexler..... Well #: 2.....
Ground surface elevation2145..... feet MSL

Well Drilled For: Well Class: Type Equipment:

Oil Storage Infield Mud Rotary
 Gas Inj Pool Ext. Air Rotary
 OWWO Expl Wildcat Cable

Domestic well within 330 feet: ___yes no
Municipal well within one mile: ___yes no

If OWWO: old well info as follows:

Operator.....
Well Name.....
Comp Date..... Old Total Depth.....

Depth to bottom of fresh water.....100'.....
Depth to bottom of usable water1200'.....

Surface pipe by Alternate: 1 ___ 2 ___
Surface pipe planned to be set200.....

I certify that well will comply with K.S.A. 55-101, et seq., plus eventually plugging holes to KCC specifications.

Date.....3/28/88..... Signature of Operator or Agent.....

Conductor pipe required.....
Projected Total Depth.....3700..... feet

Formation.....Arbuckle.....

Jeff Christian Title.....Geologist.....

For KCC Use:

Conductor Pipe Required9-28-88 feet; Minimum Surface Pipe Required200 feet per Alt. (2)

This Authorization Expires.....4-2-88..... Approved By 4-3-28-88.....

EFFECTIVE DATE: 4-2-88


Must be filed with the K.C.C. five (5) days prior to commencing well
 RECEIVED
 void if drilling not started within six (6) months of date received by K.C.C.
 STATE CORPORATION COMMISSION

Important procedures to follow:

MAK 2 6 1988
 A Regular Section of Land
 1 Mile = 5,280 Ft.

CONSERVATION DIVISION
 Wichita, Kansas

3-28-88

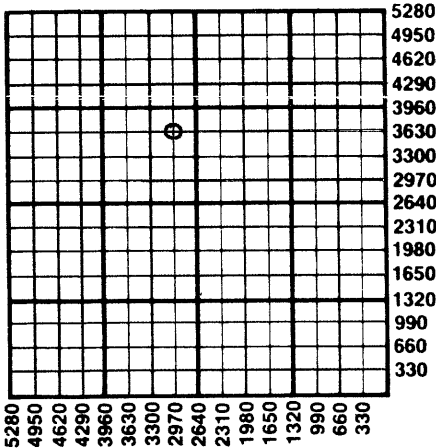

1. Notify District office before setting surface casing.
2. Set surface casing by circulating cement to the top.
3. File completion forms ACO-1 with K.C.C. within 120 days of well spud date, following instructions on ACO-1, side 1, and including copies of wireline logs.
4. Notify District office 48 hours prior to old well workover or re-entry.
5. Prior to filing Intent, prepare a proposed plugging plan in case well is D & A, then obtain approval of plan when calling district office prior to setting surface pipe.
6. Submit plugging report (CP-4) to K.C.C. after plugging is completed.
7. Obtain an approved injection docket number before disposing of salt water.
8. Notify K.C.C. within 10 days when injection commences or terminates.
9. If an alternate 2 completion, cement in the production pipe from below any usable water to surface within 120 days of spud date.

State Corporation Commission of Kansas
 Conservation Division
 200 Colorado Derby Building
 Wichita, Kansas 67202-1212
 (316) 263-3238