

RECEIVED

For KCC Use: Effective Date: 10-21-02
District #: 4
SGA? Yes No

KANSAS CORPORATION COMMISSION
OIL & GAS CONSERVATION DIVISION
NOTICE OF INTENT TO DRILL KCC WICHITA
Must be approved by KCC five (5) days prior to commencing well

Form C-1
September 1999
Form must be Typed
Form must be Signed
All blanks must be Filled

Expected Spud Date: 10-18-2002
month day year

Spot: AP SW NE SW NE Sec. 3 Twp. 7 S. R. 21
 East West

OPERATOR: License# 9449
Name: GREAT EASTERN ENERGY AND DEVELOPMENT Corp.
Address: BOX 150
City/State/Zip: BOGUE KANSAS 676254
Contact Person: Mike Davignon
Phone: 785-623-7520

1710' from north feet from N (circle one) Line of Section
1735' from east feet from E (circle one) Line of Section
Is SECTION Regular Irregular?

CONTRACTOR: License# 30606
Name: Murfin Drilling Co., Inc.

(Note: Locate well on the Section Plat on reverse side)
County: Graham
Lease Name: Billips Brothers B Well #: 3
Field Name: Unnamed

Well Drilled For: Well Class: Infield Type Equipment: Mud Rotary
 Oil Enh Rec Pool Ext. Air Rotary
 Gas Storage Wildcat Cable
 OWWO Disposal Other
 Seismic; # of Holes Other

Is this a Prorated / Spaced Field? Yes No
Target Formation(s): Granite
Nearest Lease or unit boundary: 1710'

If OWWO: old well information as follows:
Operator: _____
Well Name: _____
Original Completion Date: _____ Original Total Depth: _____

* Ground Surface Elevation: ~~2000 estimate~~ 2190 feet MSL
Water well within one-quarter mile: Yes No

Directional, Deviated or Horizontal wellbore? Yes No
If Yes, true vertical depth: _____
Bottom Hole Location: _____
KCC DKT #: _____

Public water supply well within one mile: Yes No
Depth to bottom of fresh water: ~~170~~ 150
Depth to bottom of usable water: ~~4950~~ 1150

* Special Surface Casing Rules for wells drilled in 7s.21w that are below 2000' EL.

Surface Pipe by Alternate: 1 X 2
Length of Surface Pipe Planned to be set: 225'
Length of Conductor Pipe required: NONE
Projected Total Depth: 3800'
Formation at Total Depth: Granite

Water Source for Drilling Operations:
Well _____ Farm Pond _____ Other X
DWR Permit #: _____
(Note: Apply for Permit with DWR)

Will Cores be taken? Yes No
If Yes, proposed zone: _____

AFFIDAVIT

The undersigned hereby affirms that the drilling, completion and eventual plugging of this well will comply with K.S.A. 55-101, et. seq.
It is agreed that the following minimum requirements will be met:

1. Notify the appropriate district office **prior** to spudding of well;
2. A copy of the approved notice of intent to drill **shall be** posted on each drilling rig;
3. The minimum amount of surface pipe as specified below **shall be set** by circulating cement to the top; in all cases surface pipe **shall be set** through all unconsolidated materials plus a minimum of 20 feet into the underlying formation.
4. If the well is dry hole, an agreement between the operator and the district office on plug length and placement is necessary **prior to plugging**;
5. The appropriate district office will be notified before well is either plugged or production casing is cemented in;
6. If an ALTERNATE II COMPLETION, production pipe shall be cemented from below any usable water to surface within **120 days** of spud date. **In all cases, NOTIFY district office** prior to any cementing.

I hereby certify that the statements made herein are true and to the best of my knowledge and belief.

Date: 10-11-02 Signature of Operator or Agent: [Signature] Title: AGENT

For KCC Use ONLY
API # 15 - 065-22862-00-00
Conductor pipe required NONE feet
Minimum surface pipe required 200 feet per Alt. (2)
Approved by: RJP 10-16-2002
This authorization expires: 4-16-2003
(This authorization void if drilling not started within 6 months of effective date.)
Spud date: _____ Agent: _____

- Remember to:
- File Drill Pit Application (form CDP-1) with Intent to Drill;
 - File Completion Form ACO-1 within 120 days of spud date;
 - File acreage attribution plat according to field proration orders;
 - Notify appropriate district office 48 hours prior to workover or re-entry;
 - Submit plugging report (CP-4) after plugging is completed;
 - Obtain written approval before disposing or injecting salt water.
- 3
7
21w

RECEIVED
OCT 15 2002
KCC WICHITA

IN ALL CASES PLOT THE INTENDED WELL ON THE PLAT BELOW

Plat of acreage attributable to a well in a prorated or spaced field

If the intended well is in a prorated or spaced field, please fully complete this side of the form. If the intended well is in a prorated or spaced field complete the plat below showing that the well will be properly located in relationship to other wells producing from the common source of supply. Please show all the wells and within 1 mile of the boundaries of the proposed acreage attribution unit for gas wells and within 1/2 mile of the boundaries of the proposed acreage attribution unit for oil wells.

API No. 15 - _____
Operator: Great Eastern Energy and Development Corp.
Lease: Billips Brothers B-3
Well Number: 3
Field: _____
Number of Acres attributable to well: _____
QTR / QTR / QTR of acreage: _____ - _____ - _____



Location of Well: County: Graham
1710' from north _____ feet from S / N (circle one) Line of Section
1735' from east _____ feet from E / W (circle one) Line of Section
Sec. 3 Twp. 7 S. R. 21 East West

Is Section Regular or _____ Irregular

If Section is Irregular, locate well from nearest corner boundary.
Section corner used: _____ NE _____ NW _____ SE _____ SW

PLAT

*(Show location of the well and shade attributable acreage for prorated or spaced wells.)
(Show footage to the nearest lease or unit boundary line.)*

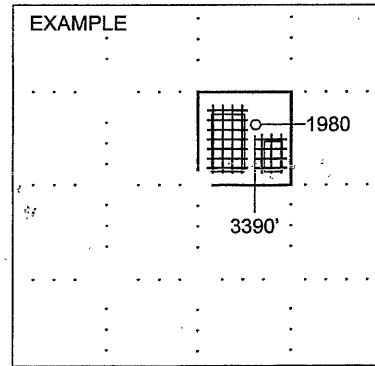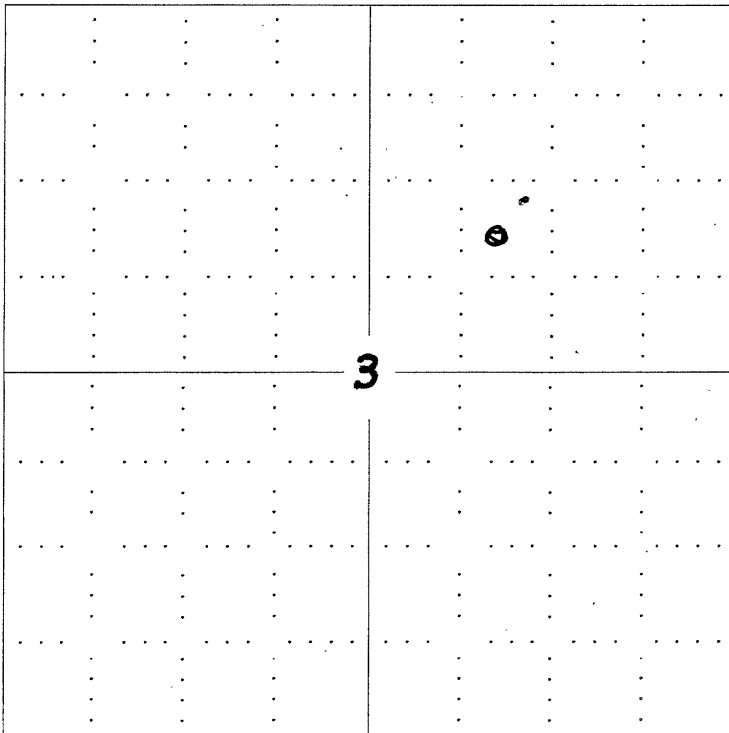

NOTE: In all cases locate the spot of the proposed drilling location.

In plotting the proposed location of the well, you must show:

1. The manner in which you are using the depicted plat by identifying section lines, i.e. 1 section, 1 section with 8 surrounding sections, 4 sections, etc.
2. The distance of the proposed drilling location from the section's south / north and east / west.
3. The distance to the nearest lease or unit boundary line.
4. If proposed location is located within a prorated or spaced field a certificate of acreage attribution plat must be attached: (CO-7 for oil wells; CG-8 for gas wells).