

CARD MUST BE TYPED

State of Kansas

CARD MUST BE SIGNED

# NOTICE OF INTENTION TO DRILL

(see rules on reverse side)

Starting Date 9 -28- 1987  
month day year

API Number 15- 121-26, 859 - 00-00

OPERATOR: License # 4648

N. W. 1/4. Sec. 36 Twp. 17 S, Rg. 21  East  
3960 West

Name Four J. Oil Company

Address Box 253

City/State/Zip Osawatomie Kansas 66064

Contact Person Paul Jackson

Phone 913.795.2586

3960 Ft. from South Line of Section

4125 Ft. from East Line of Section

(Note: Locate well on Section Plat on reverse side)

Nearest lease or unit boundary line 1155 feet

County Miami

Lease Name McKoon Well # Z-2

Ground surface elevation N/A feet MSL

Domestic well within 330 feet: —yes  no

Municipal well within one mile: —yes  no

Depth to bottom of fresh water 62'

Depth to bottom of usable water 200'

Surface pipe by Alternate: 1 2

Surface pipe planned to be set 20'

Conductor pipe required None

Projected Total Depth 350' feet

Formation Peru

Well Drilled For: Well Class: Type Equipment:

Oil  SWD  Infield  Mud Rotary

Gas  Inj  Pool Ext.  Air Rotary

OWWO  Expl  Wildcat  Cable

If OWWO: old well info as follows:

Operator

Well Name

Comp Date Old Total Depth

I certify that well will comply with K.S.A. 55-101, et seq., plus eventually plugging hole to KCC specifications.

Date 9-10-1987 Signature of Operator or Agent Paul Jackson Title Operator

For KCC Use:

Conductor Pipe Required feet; Minimum Surface Pipe Required 20 feet per Alt. X (2)


This Authorization Expires 3-16-88 Effective 9-21-87 Approved By J.H. 9-16-87

Must be filed with the K.C.C. five (5) days prior to commencing well  
This card void if drilling not started within six (6) months of date received by K.C.C.

**Important procedures to follow:**

1. Notify District office before setting surface casing.
2. Set surface casing by circulating cement to the top.
3. File completion forms ACO-1 with K.C.C. within 90 days of well completion, following instructions on ACO-1, side 1, and including copies of wireline logs.
4. Notify District office 48 hours prior to old well workover or re-entry.
5. Prior to filing Intent, prepare a proposed plugging plan in case well is D & A, then obtain approval of plan when calling district office prior to setting surface pipe.
6. Submit plugging report (CP-4) to K.C.C. after plugging is completed.
7. Obtain an approved injection docket number before disposing of salt water.
8. Notify K.C.C. within 10 days when injection commences or terminates.
9. If an alternate 2 completion, cement in the production pipe from below any usable water to surface within 120 days of spud date.

**A Regular Section of Land**  
**1 Mile = 5,280 Ft.**

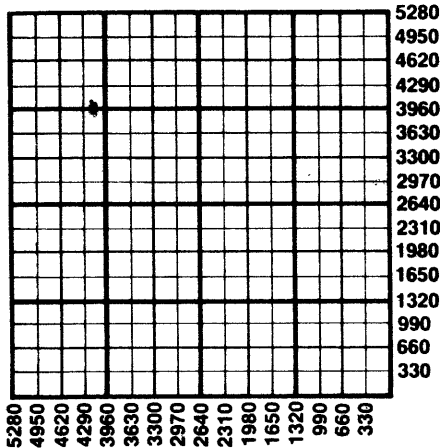

09-15-87  
SEP 15 1987  
CONSERVATION DIVISION  
Wichita, Kansas

State Corporation Commission of Kansas  
Conservation Division  
200 Colorado Derby Building  
Wichita, Kansas 67202  
(316) 263-3238