

CARD MUST BE TYPED

State of Kansas

CARD MUST BE SIGNED

NOTICE OF INTENTION TO DRILL

(see rules on reverse side)

Starting Date 9 - 28 - 1987 month day year

API Number 15-121-26,860-00-00

OPERATOR: License # 4648 Name Four J Oil Company Address Box 253 City/State/Zip Osawatomie Kansas 66064 Contact Person Paul Jackson Phone 913 795 2586

N. 1/4 Sec. 36 Twp. 17 S, Rg. 21 3960 Ft. from South Line of Section 4455 Ft. from East Line of Section

(Note: Locate well on Section Plat on reverse side)

CONTRACTOR: License # 6157 Name J & J Oil Company City/State Mound City Kansas 66056

Nearest lease or unit boundary line 825 feet County Miami

Well Drilled For: Well Class: Type Equipment: Oil SWD Infield Mud Rotary Gas Inj Pool Ext Air Rotary OWWO Expl Wildcat Cable

Lease Name McKoon Well # 8-4 Ground surface elevation N/A feet MSL

If OWWO: old well info as follows:

Domestic well within 330 feet: yes no Municipal well within one mile: yes no

Operator Well Name Comp Date Old Total Depth

Depth to bottom of fresh water 62! Depth to bottom of usable water 200!

I certify that well will comply with K.S.A. 55-101, et seq., plus eventually plugging hole to KCC specifications.

Date 9-10-1987 Signature of Operator or Agent Paul Jackson Title President

For KCC Use:

Conductor Pipe Required feet Minimum Surface Pipe Required 20 feet per Alt. X 2


This Authorization Expires 3-16-88 Effective 9-21-87 Approved By J.H. 9-16-87

Must be filed with the K.C.C. five (5) days prior to commencing well
This card void if drilling not started within six (6) months of date received by K.C.C.

Important procedures to follow:

1. Notify District office before setting surface casing.
2. Set surface casing by circulating cement to the top.
3. File completion forms ACO-1 with K.C.C. within 90 days of well completion, following instructions on ACO-1, side 1, and including copies of wireline logs.
4. Notify District office 48 hours prior to old well workover or re-entry.
5. Prior to filing Intent, prepare a proposed plugging plan in case well is D & A, then obtain approval of plan when calling district office prior to setting surface pipe.
6. Submit plugging report (CP-4) to K. C. C. after plugging is completed.
7. Obtain an approved injection docket number before disposing of salt water.
8. Notify K.C.C. within 10 days when injection commences or terminates.

A Regular Section of Land
1 Mile = 5,280 Ft.

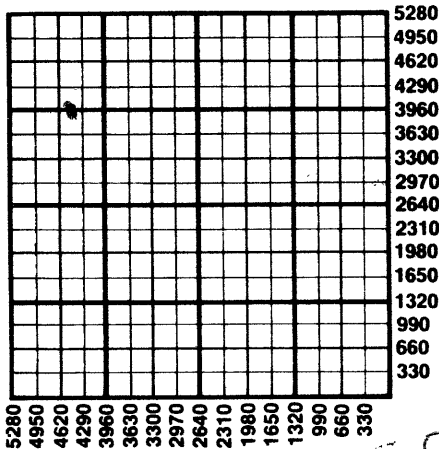

09-15-87
SEP 15 1987

CONSERVATION DIVISION
Wichita, Kansas

9. If an alternate 2 completion, cement in the production pipe from below any usable water to surface within 120 days of spud date.

State Corporation Commission of Kansas
Conservation Division
200 Colorado Derby Building
Wichita, Kansas 67202
(316) 263-3238