

CARD MUST BE TYPED

State of Kansas

CARD MUST BE SIGNED

# NOTICE OF INTENTION TO DRILL

(see rules on reverse side)

Starting Date 9-28-1987  
month day year

API Number 15-121-26,862-00-00

OPERATOR: License # 4648

East

Name Four J Oil Company

N. W. 1/4 Sec. 36 Twp. 17. S, Rg. 21 West

Address Box 253

4290 Ft. from South Line of Section

City/State/Zip Osawatomie Kansas 66064

4455 Ft. from East Line of Section

Contact Person Paul Jackson

(Note: Locate well on Section Plat on reverse side)

Phone 913-795-2586

Nearest lease or unit boundary line 825 feet

CONTRACTOR: License # 6157

County Miami

Name J & J Oil Company

Lease Name McKoon Well # BB-4

City/State Mound City Kansas 66056

Ground surface elevation N/A feet MSL

Well Drilled For: Well Class: Type Equipment:

Domestic well within 330 feet:  yes  no

- Oil  SWD  Infield  Mud Rotary
- Gas  Inj  Pool Ext.  Air Rotary
- OWWO  Expl  Wildcat  Cable

Municipal well within one mile:  yes  no

If OWWO: old well info as follows:

Depth to bottom of fresh water 62'

Operator

Depth to bottom of usable water 200'

Well Name

Surface pipe by Alternate: 1  2

Comp Date Old Total Depth

Surface pipe planned to be set 20'

I certify that well will comply with K.S.A. 55-101, et seq., plus eventually plugging hole to KCC specifications.

Conductor pipe required None

Date 9-10-1987 Signature of Operator or Agent Paul Jackson Title Painter

Projected Total Depth 350 feet

Formation Peru

For KCC Use:

Conductor Pipe Required \_\_\_\_\_ feet; Minimum Surface Pipe Required 20 feet per Alt. X (2)


This Authorization Expires 3-16-88 Effective 9-21-87 Approved By Paul Jackson 9-16-87

Must be filed with the K.C.C. five (5) days prior to commencing well  
This card void if drilling not started within six (6) months of date received by K.C.C.

**Important procedures to follow:**

1. Notify District office before setting surface casing.
2. Set surface casing by circulating cement to the top.
3. File completion forms ACO-1 with K.C.C. within 90 days of well completion, following instructions on ACO-1, side 1, and including copies of wireline logs.
4. Notify District office 48 hours prior to old well workover or re-entry.
5. Prior to filing Intent, prepare a proposed plugging plan in case well is D & A, then obtain approval of plan when calling district office prior to setting surface pipe.
6. Submit plugging report (CP-4) to K.C.C. after plugging is completed.
7. Obtain an approved injection docket number before disposing of salt water.
8. Notify K.C.C. within 10 days when injection commences or terminates.
9. If an alternate 2 completion, cement in the production pipe from below any usable water to surface within 120 days of spud date.

**A Regular Section of Land**  
**1 Mile = 5,280 Ft.**

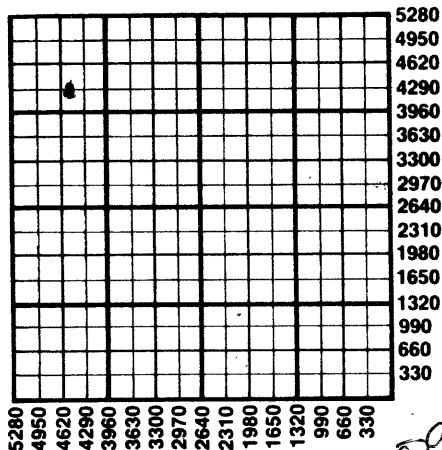

09-15-87  
SEP 15 1987  
CONSERVATION DIVISION  
Wichita, Kansas

State Corporation Commission of Kansas  
Conservation Division  
200 Colorado Derby Building  
Wichita, Kansas 67202  
(316) 263-3238