

CARD MUST BE TYPED

State of Kansas

CARD MUST BE SIGNED

### NOTICE OF INTENTION TO DRILL

(see rules on reverse side)

Expected Spud Date.....03/01/88.....  
month day year

API Number 15-121-26,888-00-00  
SE SE XX East  
NW SW SE. Sec.36... Twp.17... S, Rg.21... West  
310 Ft. from South Line of Section  
173 Ft. from East Line of Section

OPERATOR: License #.....6251.....  
Name.....Ballou Well Service.....  
Address.....Rt. #5, Box 149.....  
City/State/Zip.....Paola, Kansas.....66071.  
Contact Person.....A. E. Ballou.....  
Phone.....(913) 294-4777.....

(Note: Locate well on Section Plat on reverse side)  
Nearest lease or unit boundary line.....688..... feet  
County.....Miami.....  
Lease Name.....Gallagher..... Well #.....A-3.

CONTRACTOR: License #4441.....  
Name.....Reush Well Service.....  
City/State.....Ottawa, Kansas.....66067..

Ground surface elevation..... feet MSL  
Domestic well within 330 feet: \_\_\_\_\_ yes XX no  
Municipal well within one mile: \_\_\_\_\_ yes XX no  
Depth to bottom of fresh water.....  
Depth to bottom of usable water 200.....  
Surface pipe by Alternate: 1 \_\_\_ 2 XX  
Surface pipe planned to be set.....20.....  
Conductor pipe required.....  
Projected Total Depth.....600..... feet  
Formation.....Squirreel.....

Well Drilled For: Well Class: Type Equipment:  
XX Oil \_\_\_\_\_ Storage XX Infield XX Mud Rotary  
\_\_\_\_\_ Gas \_\_\_\_\_ Inj \_\_\_\_\_ Pool Ext. \_\_\_\_\_ Air Rotary  
\_\_\_\_\_ OWWO \_\_\_\_\_ Expl \_\_\_\_\_ Wildcat \_\_\_\_\_ Cable

If OWWO: old well info as follows:  
Operator.....  
Well Name.....  
Comp Date..... Old Total Depth.....

I certify that well will comply with K.S.A. 55-101, et seq., plus eventually plugging hole to KCC specifications.  
Date 02/29/88..... Signature of Operator or Agent *[Signature]* Title A.S. Agent.....


For KCC Use:  
Conductor Pipe Required..... feet; Minimum Surface Pipe Required..... feet per Alt. 20  
This Authorization Expires 8-29-88..... Approved By *[Signature]* 2-29-88.....

EFFECTIVE DATE: 3-5-88

Must be filed with the K.C.C. five (5) days prior to commencing well  
 This card void if drilling not started within six (6) months of date received by K.C.C.

**Important procedures to follow:**

**A Regular Section of Land  
 1 Mile = 5,280 Ft.**

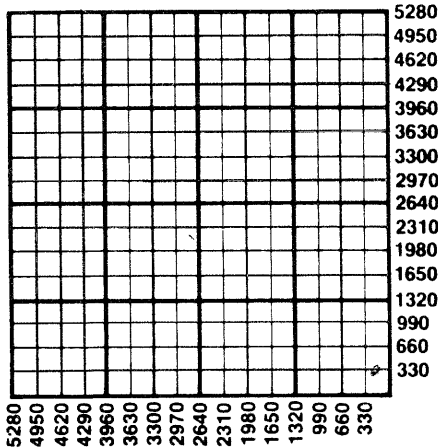

1. Notify District office before setting surface casing.
2. Set surface casing by circulating cement to the top.
3. File completion forms ACO-1 with K.C.C. within 120 days of well spud date, following instructions on ACO-1, side 1, and including copies of wireline logs.
4. Notify District office 48 hours prior to old well workover or re-entry.
5. Prior to filing Intent, prepare a proposed plugging plan in case well is D & A, then obtain approval of plan when calling district office prior to setting surface pipe.
6. Submit plugging report (CP-4) to K.C.C. after plugging is completed.
7. Obtain an approved injection docket number before disposing of salt water.
8. Notify K.C.C. within 10 days when injection commences or terminates.
9. If an alternate completion on the production pipe from below any usable water surface within 120 days of spud date.

State Corporation Commission of Kansas  
 Conservation Division

200 Colorado Derby Building  
 Wichita, Kansas 67202-1212

(316) 263-3238

02-29-88

FEB 29 1988  
 CONSERVATION DIVISION

02-29-88