

CARD MUST BE TYPED

State of Kansas

CARD MUST BE SIGNED

# NOTICE OF INTENTION TO DRILL

(see rules on reverse side)

Expected Spud Date: May 18, 1987  
month day year

API Number 15— 121-26,814-00-00

OPERATOR: License # 6251  
Ballou Oil Well Service

NW SW NW Sec. 36 Twp. 17 S, Rg. 21 X East  
3460 West

Name RR 5, Box 149

4785 Ft. from South Line of Section

Address Paola, Ks 66071

Ft. from East Line of Section

City/State/Zip Paola, Ks 66071

(Note: Locate well on Section Plat on reverse side)

Contact Person Alvin Ballou

Nearest lease or unit boundary line 165 feet

Phone 913-294-4777

County Miami

CONTRACTOR: License # 8469

Lease Name Marvin Caylor Well # B#2

Name Nickel Drilling

Ground surface elevation          feet MSL

City/State RR 1 Parker, KS 66072

Domestic well within 330 feet:          yes X no

Well Drilled For: Well Class: Type Equipment:

Municipal well within one mile:          yes X no

X Oil          Storage X Infield          Mud Rotary

Depth to bottom of fresh water         

         Gas          Inj          Pool Ext. X Air Rotary

Depth to bottom of usable water 200

         OWWO          Expl          Wildcat          Cable

Surface pipe by Alternate:          1          2 X

If OWWO: old well info as follows:

Surface pipe planned to be set 20

Operator         

Conductor pipe required         

Well Name         

Projected Total Depth 700 feet

Comp Date          Old Total Depth         

Formation Squirrel

I certify that well will comply with K.S.A. 55-101, et seq., plus eventually plugging hole to KCC specifications.

Date 5/15/87

Signature of Operator or Agent Greg Engleman Title As Agent

For KCC Use: Conductor Pipe Required          feet; Minimum Surface Pipe Required 20 feet per Alt.


This Authorization Expires 11-15-87 Approved By 5-15-87

Must be filed with the K.C.C. five (5) days prior to commencing well  
This card void if drilling not started within six (6) months of date received by K.C.C.

### Important procedures to follow:

1. Notify District office before setting surface casing.
2. Set surface casing by circulating cement to the top.
3. File completion forms ACO-1 with K.C.C. within 120 days of well spud date, following instructions on ACO-1, side 1, and including copies of wireline logs.
4. Notify District office 48 hours prior to old well workover or re-entry.
5. Prior to filing Intent, prepare a proposed plugging plan in case well is D & A, then obtain approval of plan when calling district office prior to setting surface pipe.
6. Submit plugging report (CP-4) to K.C.C. after plugging is completed.
7. Obtain an approved injection docket number before disposing of salt water.
8. Notify K.C.C. within 10 days when injection commences or terminates.
9. If an alternate 2 completion, cement in the production pipe from below any usable water to surface within 120 days of spud date.

### A Regular Section of Land 1 Mile = 5,280 Ft.

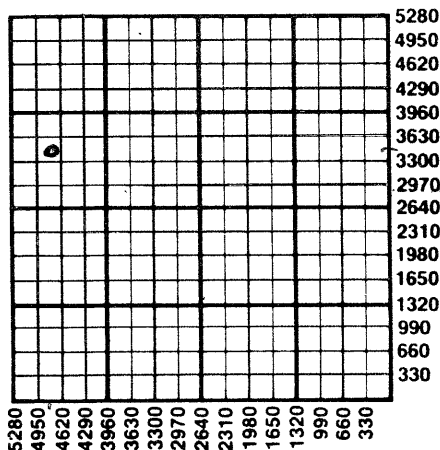

State Corporation Commission of Kansas  
Conservation Division  
200 Colorado Derby Building  
Wichita, Kansas 67202-1212  
(316) 263-3238