

CARD MUST BE TYPED

State of Kansas

CARD MUST BE SIGNED

NOTICE OF INTENTION TO DRILL

"CORRECT ~~6-12-87~~"

(see rules on reverse side)

Starting Date 2 22 87
month day year

API Number 15- 065-22, 353-00-00

OPERATOR: License # 7076

C-E/2 SE SW Sec. 22 Twp. 7 S, Rg. 22 East West

Name BLACK DIAMOND OIL, INC.

Address 1105 E. 30th, Suite A

City/State/Zip Hays, Ks. 67601

Contact Person Kenneth Vehige

Phone 913 625-5891

* 660 Ft. from South Line of Section

2970 Ft. from East Line of Section

(Note: Locate well on Section Plat on reverse side)

Nearest lease or unit boundary line 330 feet

County Graham

CONTRACTOR: License # 9087

Lease Name WORCESTER Well # 2

Name R & C DRILLING CO., INC.

Ground surface elevation 2197 feet MSL

City/State Hays, Ks. 67601

Domestic well within 330 feet: yes no

Well Drilled For: Well Class: Type Equipment:

Municipal well within one mile: yes no

X Oil SWD Infield X Mud Rotary

Depth to bottom of fresh water 150

Gas Inj X Pool Ext Air Rotary

Depth to bottom of usable water 1125

OWWO Expl Wildcat Cable

Surface pipe by Alternate: 1 2 X

If OWWO: old well info as follows:

Surface pipe planned to be set 200

Operator

Conductor pipe required 3750

Well Name

Projected Total Depth feet

Comp Date Old Total Depth

Formation Arbuckle

I certify that well will comply with K.S.A. 55-101, et seq., plus eventually plugging hole to KCC specifications.

WRS: 3300 FSL

Date 6/3/87 Signature of Operator or Agent

Opene H. Klaus

Title Secretary

For KCC Use:

Conductor Pipe Required feet; Minimum Surface Pipe Required 200 feet per Alt. 1 2


This Authorization Expires 8-19-87 Approved By 2-18-87

Must be filed with the K.C.C. five (5) days prior to commencing well
 This card void if drilling not started within six (6) months of date received by K.C.C.

Important procedures to follow:

1. Notify District office before setting surface casing.
2. Set surface casing by circulating cement to the top.
3. File completion forms ACO-1 with K.C.C. within 90 days of well completion, following instructions on ACO-1, side 1, and including copies of wireline logs.
4. Notify District office 48 hours prior to old well workover or re-entry.
5. Prior to filing Intent, prepare a proposed plugging plan in case well is D & A, then obtain approval of plan when calling district office prior to setting surface pipe.
6. Submit plugging report (CP-4) to K.C.C. after plugging is completed.
7. Obtain an approved injection docket number before disposing of salt water.
8. Notify K.C.C. within 10 days when injection commences or terminates.
9. If an alternate 2 completion, cement in the production pipe from below any usable water to surface within 120 days of spud date.

A Regular Section of Land
1 Mile = 5,280 Ft.

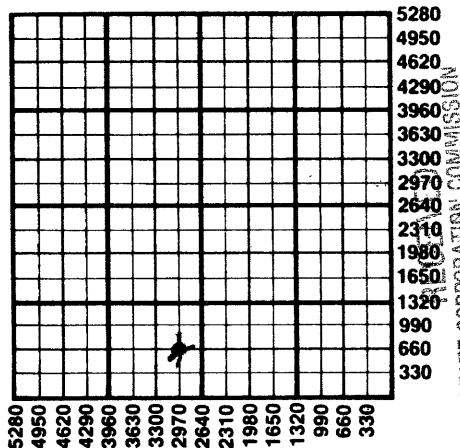

6-4-87

STATE CORPORATION COMMISSION

JUN 4 1987

CONSERVATION DIVISION
 Wichita, Kansas

State Corporation Commission of Kansas
 Conservation Division
 200 Colorado Derby Building
 Wichita, Kansas 67202
 (316) 263-3238