

CARD MUST BE TYPED

State of Kansas
NOTICE OF INTENTION TO DRILL
(see rules on reverse side)

CARD MUST BE SIGNED

Starting Date: August 15, 1984
month day year

API Number 15- 065-22,040-00
06-00

OPERATOR: License # 9087
Name R. And C. Drilling Company, Inc.
Address P.O. Box 296
City/State/Zip Hays, KS 67601
Contact Person R. L. Finney
Phone (913) 625-4548

C. S. 1/2 NW NW ... Sec. 23. Twp. 7. S, Rge 22. East
(location) West

4290 Ft North from Southeast Corner of Section
4620 Ft West from Southeast Corner of Section
(Note: Locate well on Section Plat on reverse side)

CONTRACTOR: License #
Name Company Tools
City/State

Nearest lease or unit boundary line 660 West feet.
County Graham
Lease Name Worcester Well# 05

Domestic well within 330 feet: yes no
Municipal well within one mile: yes no

Well Drilled For: Well Class: Type Equipment:
 Oil Swd Infield Mud Rotary
 Gas Inj Pool Ext. Air Rotary
 OWWO Expl Wildcat Cable

Depth to Bottom of fresh water 55 feet
Lowest usable water formation Dakota
Depth to Bottom of usable water 700 / 1100 feet
Surface pipe by Alternate: 1 2
Surface pipe to be set 200 feet
Conductor pipe if any required n/a feet
Ground surface elevation n/a feet MSL
This Authorization Expires 2/3/85
Approved By 8/3/84 [Signature]

If OWWO: old well info as follows:

Operator
Well Name
Comp Date Old Total Depth
Projected Total Depth 3800 feet
Projected Formation at TD Arbuckle
Expected Producing Formations Arbuckle

I certify that we will comply with K.S.A. 55-101, et seq., plus eventually plugging hole to K.C.C. specifications.

Date 8-2-84 Signature of Operator or Agent R. L. Finney Title President

with WOH 8/3/84

Must be filed with the K.C.C. five (5) days prior to commencing well
 This card void if drilling not started within six (6) months of date received by K.C.C.


RECEIVED
 STATE CORPORATION COMMISSION

AUG 03 1984

CONSERVATION DIVISION
 WICHITA, KANSAS

8-3-84

A Regular Section of Land
1 Mile = 5,280 Ft.

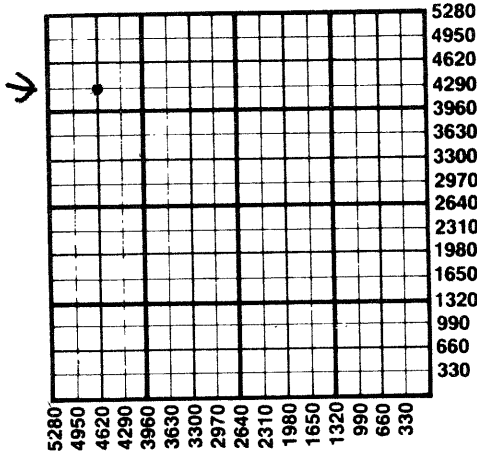

Important procedures to follow :

1. Notify District office before setting surface casing.
2. Set surface casing by circulating cement to the top.
3. File completion forms ACO-1 with K.C.C. within 90 days of well completion, following instructions on ACO-1, side 1, and including copies of wireline logs.
4. Notify District office 48 hours prior to old well workover or re-entry.
5. Prior to plugging, prepare a plugging plan, then obtain agreement from the appropriate district office for an approved plugging plan.
6. Submit plugging report (CP-4) to K.C.C. after plugging is completed.
7. Obtain an approved injection docket number before disposing of salt water.
8. Notify K.C.C. within 10 days when injection commences or terminates.
9. If an alternate 2 completion, cement in the production pipe from below any usable water to surface within 120 days of spud date.

State Corporation Commission of Kansas
Conservation Division
200 Colorado Derby Building
Wichita, Kansas 67202
(316) 263-3238