

15-065-00724-00-00

STATE OF KANSAS  
STATE CORPORATION COMMISSION

WELL PLUGGING RECORD

Give All Information Completely  
Make Required Affidavit  
Mail or Deliver Report to:  
Conservation Division  
State Corporation Commission  
800 Bitting Building  
Wichita, Kansas

Graham County. Sec. 31 Twp. 7 Rge. 22 (E) W (W)

Location as "NE/CNW/SW" or footage from lines NW NW SW

Lease Owner Nadel and Gussman

Lease Name Jones Well No. 1

Office Address 1714 First National Building, Tulsa, Okla.

Character of Well (completed as Oil, Gas or Dry Hole) Dry

Date well completed 11-10-19 55

Application for plugging filed 11-10-19 55

Application for plugging approved 11-10-19 55


Plugging commenced 11-10-19 55

Plugging completed 11-10-19 55

Reason for abandonment of well or producing formation Dry

If a producing well is abandoned, date of last production 19

Was permission obtained from the Conservation Division or its agents before plugging was commenced? Yes

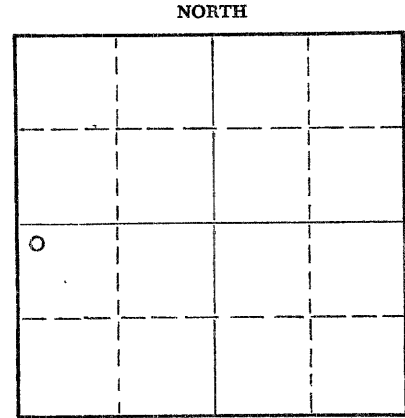

Locate well correctly on above Section Plat

Name of Conservation Agent who supervised plugging of this well Eldon Petty

Producing formation \_\_\_\_\_ Depth to top \_\_\_\_\_ Bottom \_\_\_\_\_ Total Depth of Well 3915 Feet

Show depth and thickness of all water, oil and gas formations.

OIL, GAS OR WATER RECORDS

CASING RECORD

FORMATION	CONTENT	FROM	TO	SIZE	PUT IN	PULLED OUT
				8-5/8"	150	0

Describe in detail the manner in which the well was plugged, indicating where the mud fluid was placed and the method or methods used in introducing it into the hole. If cement or other plugs were used, state the character of same and depth placed, from \_\_\_\_\_ feet to \_\_\_\_\_ feet for each plug set.

Filled hole with heavy mud from total depth to 145' - set plug with 15 sacks cement

Filled hole with heavy mud to 40' of top - set plug with 10 sacks of cement

RECEIVED  
STATE CORPORATION COMMISSION  
NOV 21 1955  
CONSERVATION DIVISION  
WICHITA, KANSAS  
11/29/55

(If additional description is necessary, use BACK of this sheet)

Name of Plugging Contractor Reserve Drilling Company, Inc.  
Address 703 Union National Building, Wichita 2, Kansas

STATE OF KANSAS, COUNTY OF SEDGWICK, ss.  
George A. Reed (employee of owner) ~~or owner or operator~~ of the above-described

well, being first duly sworn on oath, says: That I have knowledge of the facts, statements, and matters herein contained and the log of the above-described well as filed and that the same are true and correct. So help me God.

(Signature) George A. Reed  
Wichita, Kansas  
(Address)

SUBSCRIBED AND SWORN TO before me this 14th day of November, 1955

My commission expires Nov. 3, 1956  
Nola Babb Notary Public.

PLUGGING  
FILE SEC 31 T 7 R 22 W  
BOOK PAGE 15 LINE 39

WELL LOG

15-065-00724-00-00

Nadel and Gussman

JONES No. 1

NW NW SW 31-7-22W  
Graham County, Kansas

Comm: 11- 1-55  
Comp: 11-10-55

Casing: 8-5/8" 150' W/125 Sax

<u>Formation</u>	<u>Depth</u>
Surface	150
Shale and shells	970
Sand	1030
Shale and shells	1300
Shale, shells and red bed	1430
Sand	1590
Shale and red bed	1898
Anhydrite	1935
Shale and red bed	2250
Shale and lime	2450
Shale	2620
Shale and lime	3540
Lime	3753
Cong.	3785
Shale	3900
Dolomite	3915

Geological Tops

Howard Limestone	3295
Topeka	3325
Heebner Shale	3510
Toronto Limestone	3521
Lansing-Kansas City	3548
Base Kansas City	3753
Marmaton	3774
Arbuckle	3897

STATE OF KANSAS

COUNTY OF SEDGWICK

}  
SS:

George A. Reed, of lawful age, states that the above formations and depths are correct as shown by the daily drilling log of the Jones No. 1 Well in the NW NW SW 31-7-22W, Graham County, Kansas.

*George A. Reed*  
George A. Reed

Subscribed and sworn to before me this 14th day of November, 1955.

*Nola Babb*  
Nola Babb, Notary Public

My commission expires Nov. 3, 1956

**PLUGGING**  
NW SW 31 T 7 R 22W  
BOOK PAGE 15 LINE 39

NOV 15 1955  
NOTARY PUBLIC  
11/27/55