


WELL PLUGGING RECORD

Give All Information Completely  
Make Required Affidavit  
Mail or Deliver Report to:  
Conservation Division  
State Corporation Commission  
212 No. Market  
Wichita, Kansas

Graham County. Sec. 30 Twp. 7S Rge. 17-22(W)  
Location as "NE/CNW%SW%" or footage from lines SW SW NE  
Lease Owner Burch Exploration, Inc.  
Lease Name DAVIS Well No. 1  
Office Address 1011 Union Center, Wichita, Kansas  
Character of Well (completed as Oil, Gas or Dry Hole) Dry Hole  
Date well completed January 8, 19 67  
Application for plugging filed (verbally) January 7, 19 67  
Application for plugging approved (verbally) January 7, 19 67  
Plugging commenced January 8, 19 67  
Plugging completed January 8, 19 67  
Reason for abandonment of well or producing formation Dry Hole

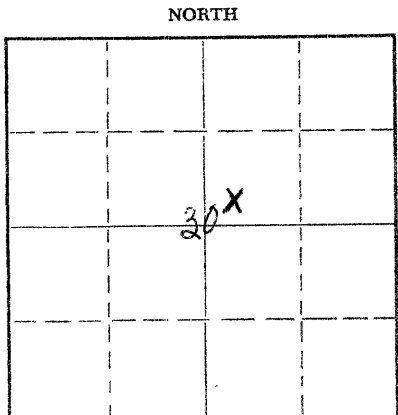

Locate well correctly on above Section Plat

If a producing well is abandoned, date of last production 19  
Was permission obtained from the Conservation Division or its agents before plugging was commenced? Yes

Name of Conservation Agent who supervised plugging of this well W. L. Nichols, Morland, Kansas  
Producing formation \_\_\_\_\_ Depth to top \_\_\_\_\_ Bottom \_\_\_\_\_ Total Depth of Well 3690 Feet  
Show depth and thickness of all water, oil and gas formations.

OIL, GAS OR WATER RECORDS

CASING RECORD

FORMATION	CONTENT	FROM	TO	SIZE	PUT IN	PULLED OUT
				7"	218'	None

RECEIVED  
JAN 11 1967  
1/11/67  
CONSERVATION DIVISION  
Wichita, Kansas

Describe in detail the manner in which the well was plugged, indicating where the mud fluid was placed and the method or methods used in introducing it into the hole. If cement or other plugs were used, state the character of same and depth placed, from \_\_\_\_\_ feet to \_\_\_\_\_ feet for each plug set.

Filled hole with heavy mud to 610'. Set 1st plug at 610' with 15 sacks of cement thru drill pipe. Filled hole to 210' with heavy mud. Set 2nd plug at 210' with 1/4 sack of hulls and 15 sacks of cement thru drill pipe. Set 3rd plug at 40 feet with 1/4 sack of hulls and 8 sacks of cement. Put 2 sacks of cement in rat hole.

(If additional description is necessary, use BACK of this sheet)

Name of Plugging Contractor Abercrombie Drilling, Inc.  
Address West 10th Street, Great Bend, Kansas

STATE OF KANSAS, COUNTY OF SEDGWICK, ss.  
Jack K. Whaton (employee of owner) or (~~owner/operator~~) of the above-described well, being first duly sworn on oath, says: That I have knowledge of the facts, statements, and matters herein contained and the log of the above-described well as filed and that the same are true and correct. So help me God.

(Signature) Jack K. Whaton  
801 Union Center, Wichita, Kansas  
(Address)

SUBSCRIBED AND SWORN TO before me this 10th day of January, 1967

My commission expires March 31, 1970.

Margo Dee Montgomery  
Notary Public.

15-065-30214-00-00

CONTRACTOR'S WELL LOG

COMPANY: Burch Exploration, Inc.  
 CONTRACTOR: Abercrombie Drilling, Inc.  
 FARM: Davis #1  
 LOCATION: SW SW NE, Section 30-7S-22W  
 Graham County, Kansas  
 COMMENCED: December 31, 1966  
 COMPLETED: January 8, 1967

0	234	Surface soil, clay and shale
234	700	Shale
700	1000	Sand
1000	1110	Shale
1110	1617	Shale and Shells
1617	1830	Shale & Red Beds
1830	1861	Anhydrite
1861	2320	Shale
2320	3252	Shale and Lime
3252	3521	Lime and Shale
3521	3660	Lime
3660	3690	Lime and Shale
	3690	Rotary Total Depth

RECEIVED  
 STATE CORPORATION COMMISSION  
 JAN 11 1967  
 CONSERVATION DIVISION  
 Wichita, Kansas  
 1/11/67

Set 7" surface casing at 218 feet with 125 sacks of cement.

Dry and Abandoned.

ELECTRIC LOG TOPS:

Anhydrite (Driller)	1830	+ 410
Heebner	3438	-1198
Toronto	3466	-1226
Lansing	3482	-1242
Base/Kansas City	3675	-1435
Total Depth	3691	-1451

ELEVATION: 2240 K.B.  
 2239 D.F.  
 2233 G.L.

STATE OF KANSAS )  
 ) SS  
 COUNTY OF SEDGWICK )

I, Jack K. Wharton, do hereby certify that the above and foregoing is a true and correct copy of the log of the Davis #1, SW NE NE, Section 30-7S-22W, Graham County, Kansas, as reflected by the files of Abercrombie Drilling, Inc.

*Jack K. Wharton*  
 Jack K. Wharton

Subscribed and sworn to before me, a Notary Public, in and for Sedgwick County, Kansas, this 9th day of January, 1967.

*Margo Dee Montgomery*  
 Margo Dee Montgomery, Notary Public

My commission expires: March 31, 1970.

