

CARD MUST BE TYPED

State of Kansas

CARD MUST BE SIGNED

NOTICE OF INTENTION TO DRILL

(see rules on reverse side)

Starting Date June 25, 1987
month day year

API Number 15— 065-22,387-00-00

OPERATOR: License # 5663
Name Hess Oil Company
Address P.O. Box 1009
City/State/Zip McPherson, KS 67460
Contact Person James C. Hess
Phone 316-263-2243

NE SW NW Sec. 19 Twp. 7 S, Rg. 22 East
3630 West
4290
Ft. from South Line of Section
Ft. from East Line of Section

(Note: Locate well on Section Plat on reverse side)

CONTRACTOR: License # 4958
Name Mallard JV, Inc.
City/State McPherson, KS 67460

Nearest lease or unit boundary line 990 feet
County Graham
Lease Name Steward Well # 1
Ground surface elevation 2280 est. feet MSL

Well Drilled For: Well Class: Type Equipment:
 Oil SWD Infield Mud Rotary
 Gas Inj Pool Ext. Air Rotary
 OWWO Expl Wildcat Cable

Domestic well within 330 feet: yes no
Municipal well within one mile: yes no

If OWWO: old well info as follows:
Operator
Well Name
Comp Date Old Total Depth

Depth to bottom of fresh water. 180 200+
Depth to bottom of usable water. ~~200~~ 1200
Surface pipe by Alternate: 1 2
Surface pipe planned to be set 200'
Conductor pipe required
Projected Total Depth 3750 feet
Formation Lansing

I certify that well will comply with K.S.A. 55-101, et seq., plus eventually plugging hole to KCC specifications.
Date 6/5/87 Signature of Operator or Agent Title Bryan Hess, Mgr.

For KCC Use:
Conductor Pipe Required _____ feet; Minimum Surface Pipe Required 200 feet per Alt. 4
This Authorization Expires 12-8-87 Approved By 6-8-87


[Handwritten signature]

Must be filed with the K.C.C. five (5) days prior to commencing well
 This card void if drilling not started within six (6) months of date received by K.C.C.

Important procedures to follow:

1. Notify District office before setting surface casing.
2. Set surface casing by circulating cement to the top.
3. File completion forms ACO-1 with K.C.C. within 90 days of well completion, following instructions on ACO-1, side 1, and including copies of wireline logs.
4. Notify District office 48 hours prior to old well workover or re-entry.
5. Prior to filing Intent, prepare a proposed plugging plan in case well is D & A, then obtain approval of plan when calling district office prior to setting surface pipe.
6. Submit plugging report (CP-4) to K. C. C. after plugging is completed.
- Obtain an approved injection docket number before disposing of salt water.
- Notify K.C.C. within 10 days when injection commences or terminates.
9. If an alternate 2 completion, cement in the production pipe from below any usable water to surface within 120 days of spud date.

A Regular Section of Land
1 Mile = 5,280 Ft.

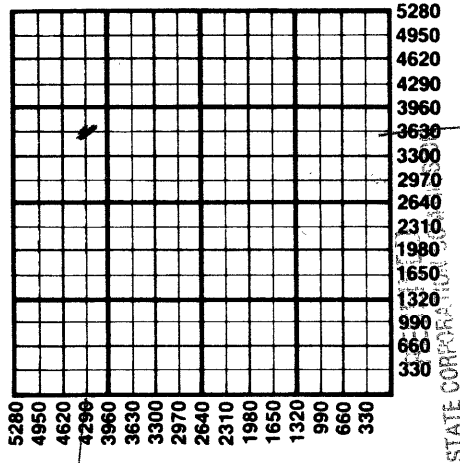

JUN 8 1987
 JUN 8 1987
 CONSERVATION DIVISION
 Wichita, Kansas

State Corporation Commission of Kansas
 Conservation Division
 200 Colorado Derby Building
 Wichita, Kansas 67202
 (316) 263-3238