

CARD MUST BE TYPED

State of Kansas  
**NOTICE OF INTENTION TO DRILL**  
(see rules on reverse side)

CARD MUST BE SIGNED

Starting Date: Nov. 4, 1984  
month day year

API Number 15-065-22,101 0000

OPERATOR: License # 5004  
Name Vincent Oil Corporation  
Address 125 N. Market, Suite #1110  
City/State/Zip Wichita, Ks. 67202  
Contact Person Ruth Benjamin  
Phone (316) 262-3573

.C. NE SE. NE. Sec 32. Twp .7. S, Rge 22. East West

3630 Ft North from Southeast Corner of Section  
330 Ft West from Southeast Corner of Section  
(Note: Locate well on Section Plat on reverse side)

CONTRACTOR: License # 5422  
Name Abercrombie Drilling, Inc.  
City/State Wichita, Ks. 67202

Nearest lease or unit boundary line 330 feet.  
County Graham  
Lease Name Worcester "B" Well# 1

Domestic well within 330 feet:  yes  no  
Municipal well within one mile:  yes  no

Well Drilled For: Well Class: Type Equipment:  
 Oil  Swd  Infield  Mud Rotary  
 Gas  Inj  Pool Ext.  Air Rotary  
 OWWO  Expl  Wildcat  Cable

Depth to Bottom of fresh water 75 feet  
Lowest usable water formation Dakota  
Depth to Bottom of usable water 1100 feet  
Surface pipe by Alternate: 1 2 1  
Surface pipe to be set 285' 8-5/8" feet  
Conductor pipe if any required N/A feet  
Ground surface elevation called for feet MSI

If OWWO: old well info as follows:

Operator  
Well Name  
Comp Date Old Total Depth  
Projected Total Depth 3850 feet  
Projected Formation at TD Arbuckle  
Expected Producing Formations

This Authorization Expires 1-30-85  
Approved By 10-30-84

I certify that we will comply with K.S.A. 55-101, et seq., plus eventually plugging hole to K.C.C. specifications.

Date 10-30-84 Signature of Operator or Agent

Richard A. Hiebsch

Vice President


Must be filed with the K.C.C. five (5) days prior to commencing well  
 This card void if drilling not started within six (6) months of date received by K.C.C.

RECEIVED  
 STATE CORPORATION COMMISSION

Important procedures to follow:

OCT 30 1984  
 10/30/84  
 MUNICIPAL DISTRICT  
 WICHITA, KANSAS

**A Regular Section of Land**  
 1 Mile = 5,280 Ft.

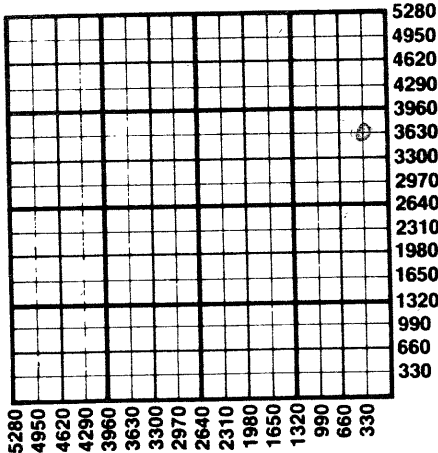

1. Notify District office before setting surface casing.
2. Set surface casing by circulating cement to the top.
3. File completion forms ACO-1 with K.C.C. within 90 days of well completion, following instructions on ACO-1, side 1, and including copies of wireline logs.
4. Notify District office 48 hours prior to old well workover or re-entry.
5. Prior to plugging, prepare a plugging plan, then obtain agreement from the appropriate district office for an approved plugging plan.
6. Submit plugging report (CP-4) to K.C.C. after plugging is completed.
7. Obtain an approved injection docket number before disposing of salt water.
8. Notify K.C.C. within 10 days when injection commences or terminates.
9. If an alternate 2 completion, cement in the production pipe from below any usable water to surface within 120 days of spud date.

State Corporation Commission of Kansas  
 Conservation Division  
 200 Colorado Derby Building  
 Wichita, Kansas 67202  
 (316) 263-3238