

CARD MUST BE TYPED

State of Kansas
NOTICE OF INTENTION TO DRILL

CARD MUST BE SIGNED

(see rules on reverse side)

Starting Date: Sept. 5 1984
month day year

API Number 15- 065-22,0640000

OPERATOR: License # 5238
Name Petroleum, Inc.
Address 300 W. Douglas, Suite 800
City/State/Zip Wichita, Ks. 67202
Contact Person Monte Chadd
Phone 316-793-8471

NW SW SW Sec 34 Twp 7 S, Rge 22
(location)
990 Ft North from Southeast Corner of Section
4950 Ft West from Southeast Corner of Section
(Note: Locate well on Section Plat on reverse side)

CONTRACTOR: License # 5476
Name DNB Drilling, Inc.
City/State 535 N. Oliver, Wichita, Ks. 67208

Nearest lease or unit boundary line 330 feet.
County Graham
Lease Name Rowe Well# 1

Well Drilled For: Well Class: Type Equipment:
 Oil Swd Infield Mud Rotary
 Gas Inj Pool Ext. Air Rotary
 OWWO Expl Wildcat Cable

Domestic well within 330 feet: yes no
Municipal well within one mile: yes no

Depth to Bottom of fresh water 170 feet
Lowest usable water formation Dakota
Depth to Bottom of usable water 975 feet
Surface pipe by Alternate: 1 2
Surface pipe to be set 250 feet
Conductor pipe if any required - feet
Ground surface elevation - feet MSL

This Authorization Expires 3-2-85
Approved By J. 3074 [Signature]

If OWWO: old well info as follows:
Operator
Well Name
Comp Date Old Total Depth
Projected Total Depth 3900 feet
Projected Formation at TD
Expected Producing Formations

I certify that we will comply with K.S.A. 55-101, et seq., plus eventually plugging holes to K.C.C. specifications.


Date 8-30-84 Signature of Operator or Agent [Signature] Title District Landman

Form C-1 4/84

MHC/KOHE 8/30/84

**Must be filed with the K.C.C. five (5) days prior to commencing well
This card void if drilling not started within six (6) months of date received by K.C.C.**

**A Regular Section of Land
1 Mile = 5,280 Ft.**

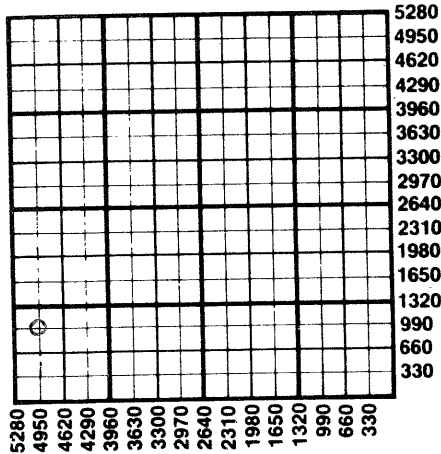

Important procedures to follow :

1. Notify District office before setting surface casing.
2. Set surface casing by circulating cement to the top.
3. File completion forms ACO-1 with K.C.C. within 90 days of well completion, following instructions on ACO-1, side 1, and including copies of wireline logs.
4. Notify District office 48 hours prior to old well workover or reentry.
5. Prior to plugging, prepare a plugging plan, then obtain agreement from the appropriate district office for an approved plugging plan.
6. Submit plugging report (CP-4) to K.C.C. after plugging is completed.
7. Obtain an approved injection docket number before disposing of salt water.
8. Notify K.C.C. within 10 days when injection commences or terminates.
9. If an alternate 2 completion, cement in the production pipe from below any usable water to surface within 120 days of spud date.

RECEIVED
 STATE CORPORATION
 AUG 27 1984
 CURTIS, WICHITA, KANSAS

**State Corporation Commission of Kansas
 Conservation Division
 200 Colorado Derby Building
 Wichita, Kansas 67202
 (316) 263-3238**