

15-065-21000-00-00


STATE OF KANSAS
STATE CORPORATION COMMISSION

WELL PLUGGING RECORD

Give All Information Completely
Make Required Affidavit
Mail or Deliver Report to
Conservation Division
State Corporation Comm.
245 North Water
Wichita, KS 67202

Graham County, Sec. 32 Twp. 7 S Rge. 22 E/W
Location as "NE/CNW 1/4 SW 1/4" or footage from lines
SE SW SE

Lease Owner Ram Petroleum, Inc.
Lease Name Worcester Well No. 1
Office Address 800 Vickers KSB&T Bldg., Wichita, Kansas 67202
Character of Well (Completed as Oil, Gas or Dry Hole)
Dry Hole

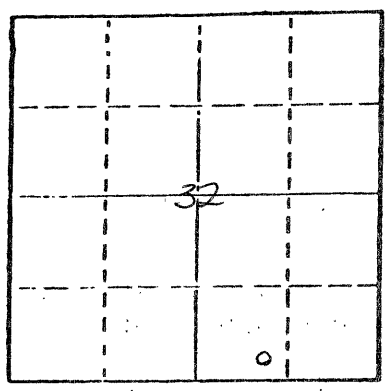

Locate well correctly on above
Section Plat

Date Well completed May 5, 1978
Application for plugging filed (verbally) May 5, 1978
Application for plugging approved (verbally) May 5, 1978
Plugging commenced May 5, 1978
Plugging completed May 5, 1978

Reason for abandonment of well or producing formation
No commercial quantity of oil or gas encountered
If a producing well is abandoned, date of last production 19

Was permission obtained from the Conservation Division or
its agents before plugging was commenced? Yes

Name of Conservation Agent who supervised plugging of this well Gilbert Balthazor
Producing formation _____ Depth to top _____ Bottom _____ Total Depth of Well 3784
Show depth and thickness of all water, oil and gas formations.

OIL, GAS OR WATER RECORDS

CASING RECORD

FORMATION	CONTENT	FROM	TO	SIZE	PUT IN	PULLED OUT

Describe in detail the manner in which the well was plugged, indicating where the mud fluid
was placed and the method or methods used in introducing it into the hold. If cement or other
plugs were used, state the character of same and depth placed, from _____ feet to
_____ feet for each plug set.

Set 1st plug at 850' with 70 sacks
2nd plug at 240' with 20 sacks
40' solid bridge with 10 sacks
Cemented with 50/50 posmix

RECEIVED
STATE CORPORATION COMMISSION
MAY 12 1978
CONSERVATION DIVISION
Wichita, Kansas
5/12/78

(If additional description is necessary, use BACK of this sheet)

Name of Plugging Contractor Abercrombie Drilling, Inc.

STATE OF KANSAS COUNTY OF SEDGWICK ss:
Jack L. Partridge, Ass't. Sec.-Treas.

well, being first duly sworn on oath, says: That I have knowledge of the facts, statements, and matters herein contained and the log of the
above-described well as filed and that the same are true and correct. So help me God.

(Signature) Jack L. Partridge
801 Union Center, Wichita, Kansas 67202
(Address)



Subscribed and sworn to before me this 10th day of May, 1978
My commission expires July 21, 1979
Sandra Richman
Sandra Richman Notary Public

OPERATOR: Ram Petroleum, Inc.
 CONTRACTOR: Abercrombie Drilling, Inc.
 WELL NAME: Worcester #1
 LOCATION: SE SW SE Section 32-7S-22W
 Graham County, Kansas
 SPUD DATE: April 28, 1978
 COMPLETION DATE: May 5, 1978

0	331	Clay, sand & shale
331	525	Sand & shale
525	1805	Shale & sand
1805	1838	Anhydrite
1838	1880	Shale
1880	2300	Sand & shale
2300	2805	Shale & lime
2805	3784	Lime
	3784	Rotary Total Depth

Spud at 3:00 p.m., April 28, 1978. Drilled 331' of 12 1/4" hole. Ran 8 joints of 8-5/8" surface casing. Set at 330' K.B. with 130 sacks 60/40 posmix, 3% CaCl, 2% gel. Job complete at 8:00 p.m., April 28, 1978.

T.D. 3784'. Set first plug at 850' with 70 sacks, second plug at 240' with 20 sacks, 40' solid bridge with 10 sacks. Cemented with 50/50 posmix. Plug was down at 10:00 p.m., May 5, 1978. State Plugger - Gilbert Balthazor.

SAMPLE TOPS:

Anhydrite 1805'
 B/Anhydrite 1838'

RECEIVED
 STATE CORPORATION COMMISSION
 MAY 12 1978
 CONSERVATION DIVISION
 Topeka, Kansas

5/12/78


STATE OF KANSAS)
) ss
 COUNTY OF SEDGWICK)

Jack L. Partridge, Assistant Secretary-Treasurer of Abercrombie Drilling, Inc., does hereby state that the above and foregoing is a true and correct copy of the log of the Worcester #1, SE SW SE Section 32-7S-22W, Graham County, Kansas.

ABERCROMBIE DRILLING, INC.

By Jack L. Partridge
 Jack L. Partridge,
 Assistant Secretary-Treasurer

Subscribed and sworn to before me, a Notary Public, in and for the county and state aforesaid, as of this 10th day of May, 1978.

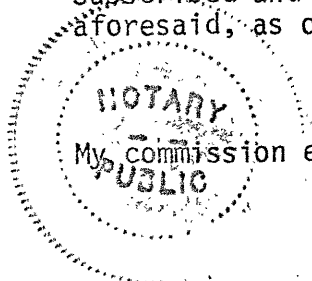

Sandra Richman
 Sandra Richman, Notary Public