


Give All Information Completely
Make Required Affidavit
Mail or Deliver Report to:
Conservation Division
State Corporation Commission
800 Biting Building
Wichita, Kansas

OR

FORMATION PLUGGING RECORD

Strike out upper line
when reporting plug-
ging off formations.

Graham County. Sec. 33 Twp. 7S Rge. 22W (E).....(W)
Location as "NE $\frac{1}{4}$ NW $\frac{1}{4}$ SW $\frac{1}{4}$ " or footage from lines SW SW SE
Lease Owner. Anderson-Prichard Oil Corporation
Lease Name. Morris Well No. 1
Office Address. Oklahoma City, Oklahoma
Character of Well (completed as Oil, Gas or Dry Hole) Dry hole
Date well completed October 8 1947
Application for plugging filed (Verbal) October 8, 1947
Application for plugging approved (Verbal) October 8, 1947
Plugging commenced October 8, 1947
Plugging completed October 8, 1947
Reason for abandonment of well or producing formation.....

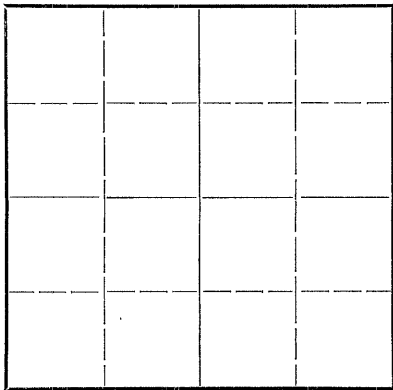

Locate well correctly on above
Section Plat

If a producing well is abandoned, date of last production.....19.....
Was permission obtained from the Conservation Division or its agents before plugging was com-
menced?.....Yes

Name of Conservation Agent who supervised plugging of this well.....C. D. Stough
Producing formation..... Depth to top..... Bottom..... Total Depth of Well 3783 Feet
Show depth and thickness of all water, oil and gas formations.

OIL, GAS OR WATER RECORDS

CASING RECORD

Formation	Content	From	To	Size	Put In	Pulled Out
				10 3/8	299	None

Describe in detail the manner in which the well was plugged, indicating where the mud fluid was placed and the method or methods used in introducing it into the hold. If cement or other plugs were used, state the character of same and depth placed, from.....feet to.....feet for each plug set.

Filled with heavy mud to 299 feet. Set Halliburton plug @ 299' and plugged with 15 sacks of cement. Filled with heavy mud to 15'. Set Halliburton plug @ 15' and plugged with 15 sacks of cement. Placed 10 sacks of cement in cellar.

(If additional description is necessary, use BACK of this sheet)

Correspondence regarding this well should be addressed to Anderson-Prichard Oil Corporation 10/25/47
Address Oklahoma City, Oklahoma

STATE OF Kansas, COUNTY OF Sedgwick, SS.
M. W. Smith (employee of owner) or ~~XXXXXXXXXX~~ of the above-described well, being first duly sworn on oath, says: That I have knowledge of the facts, statements, and matters herein contained and the log of the above-described well as filed and that the same are true and correct. So help me God.

(Signature) M. W. Smith
Wichita, Kansas (Address)

SUBSCRIBED AND SWORN to before me this 20th day of October, 1947.

My commission expires January 21, 1950
Patricia Meeker Notary Public.

PLUGGING
FILE SEC 32 T 7 R 224
BOOK PAGE 139-27

WILLIAMS LOG OF FORMATIONS ENCOUNTERED IN

ATKINS-PRICHARD OIL WELL

WELL NO. 1


WELL DEPTH, FEET

FORMATION	FROM	TO	
Sand, silt & shale	0	100	
Shale & shells	100	200	
Shale, shells & red sand	200	1500	Set 200' 1 1/2" casing
Sand & shells	1500	1715	and cement of 2 1/2" cas.
Sand	1715	1800	Casing.
Shale & shells	1800	2400	
Shale & lime	2400	2875	
Lime	2875	3100	
Lime & shale	3100	3400	

REC'D DATE
11/8/47

ED. D. A. 1947

Contractor - Frank's Corporation
1000 Tower
Chicago, Ill., U.S.A.

I hereby certify the foregoing to be a true and correct drilling log of the formations encountered in the above well.

PLUGGING
FILE SEC 37 7-200
BOOK PAGE 139 LINE 27

Victor C. Davis
Inspector

Witnessed to before me this 5th day of November, 1947

Betty Jean Scott
Notary Public

My Commission Expires Mar 7, 1951