


STATE OF KANSAS
STATE CORPORATION COMMISSION

15-065-60872-00-00

Give All Information Completely
Make Required Affidavit
Mail or Deliver Report to:
Conservation Division
State Corporation Commission
211 No. Broadway
Wichita, Kansas

WELL PLUGGING RECORD

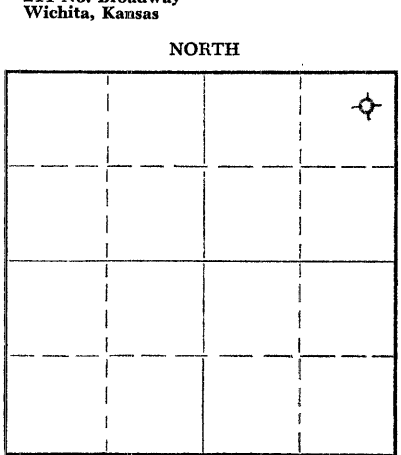

Locate well correctly on above
Section Plat

Graham County, Sec. 33 Twp. 7 Rge. 22 (E) W (W)
Location as "NE/CNW/SW" or footage from lines NE NE NE
Lease Owner D. G. Hansen
Lease Name Worcester Well No. 1
Office Address Logan, Kansas
Character of Well (completed as Oil, Gas or Dry Hole) Dry Hole
Date well completed September 24 19 56
Application for plugging filed September 24 19 56
Application for plugging approved September 24 19 56
Plugging commenced September 25 19 56
Plugging completed September 25 19 56
Reason for abandonment of well or producing formation Too low structurally

If a producing well is abandoned, date of last production _____ 19 ____
Was permission obtained from the Conservation Division or its agents before plugging was commenced? Yes

Name of Conservation Agent who supervised plugging of this well Eldon Petty, Hays, Kansas
Producing formation _____ Depth to top _____ Bottom _____ Total Depth of Well 3839 Feet
Show depth and thickness of all water, oil and gas formations.

OIL, GAS OR WATER RECORDS

CASING RECORD

FORMATION	CONTENT	FROM	TO	SIZE	PUT IN	PULLED OUT
				8-5/8"	200'	none

Describe in detail the manner in which the well was plugged, indicating where the mud fluid was placed and the method or methods used in introducing it into the hole. If cement or other plugs were used, state the character of same and depth placed, from _____ feet to _____ feet for each plug set.

Filled with heavy mud to 195'. Set plug.
Put in 15 sacks cement and 1/2 sack Hulls.
Filled with heavy mud up to 40'. Set plug.
Filled to top with 10 sacks cement and 1/2 sack Hulls.

9/27/56

(If additional description is necessary, use BACK of this sheet)
Name of Plugging Contractor C-G Drilling Co.
Address 107 Rule Building, Wichita, Kansas

STATE OF KANSAS, COUNTY OF SEDGWICK, ss.
G. F. Galloway (employee of owner) or (owner or operator) of the above-described well, being first duly sworn on oath, says: That I have knowledge of the facts, statements, and matters herein contained and the log of the above-described well as filed and that the same are true and correct. So help me God.

(Signature) *G. F. Galloway*
G. F. Galloway
107 Rule Bldg. (Address)

SUBSCRIBED AND SWORN TO before me this 28th day of September, 1956

My commission expires May 20, 1959
Vicky Jacobs Notary Public.

PLUGGING
FILE SEC 33 T. 7 R. 22W
BOOK PAGE 103 LINE 12

15-065-00872-00-00

CONTRACTOR'S WELL LOG

OPERATOR D. G. HANSEN WELL NAME WORCESTER #1

LOCATION NE NE NE SECTION 33-7-22W RIG NO. 1

COUNTY GRAHAM STATE KANSAS

COMMENCEMENT DATE SEPTEMBER 16, 1956 COMPLETION DATE SEPTEMBER 24, 1956

LOG OF WELL

Elevation 2215' rotary bushing.
All measurements taken from the top of rotary bushing.

FROM	TO	FORMATION	DEVIATION FROM VERTICAL	REMARKS
0	200	Surface Soil		
200	760	Shale		
760	845	Sand		
845	1200	Shale		
1200	1310	Shale		
1310	1550	Red Bed		
1550	1841	Anhydrite		
1841	1900	Shale		
1900	2235	Shale-Shells		
2235	2465	Shale-Shells		
2465	2615	Lime-Shale	0° - 2500	
2615	2770	Shale-Lime	0° - 2750	
2770	2870	Lime-Shale		
2870	2975	Lime-Shale		
2975	3135	Lime-Shale	0° - 3000	
3135	3245	Lime-Shale		
3245	3345	Lime-Shale	0° - 3250	
3345	3420	Lime-Shale		
3420	3491	Lime-Shale		
3491	3529	Lime-Shale	0° - 3500	
3529	3622	Lime-Shale		DST 3607-22
3622	3680	Lime		DST 3624-42
3680	3740	Lime-Shale		
3740	3782	Lime-Shale Chert	0° - 3750	
3782	3839	Lime-Shale		

CASING LEFT IN HOLE AFTER COMPLETION

200' (10 jts.) 8-5/8" OD Surface Casing.

STATE OF KANSAS)
COUNTY OF SEDGWICK) SS.

7/29/56

The undersigned hereby certifies that to the best of his knowledge and belief, the above facts are true and correct.

C-G DRILLING CO.

By [Signature]

Subscribed and sworn to before me this 28th day of September, 1956.

My commission expires: May 20, 1959

[Signature]
Vicky Jacobs, Notary Public

PLUGGING
FILE SEC 33 T 7 R 22W
BOOK PAGE 103 LINE 12