

15-065-00289-00-00

STATE OF KANSAS
STATE CORPORATION COMMISSION

WELL PLUGGING RECORD


OR

FORMATION PLUGGING RECORD

Strike out upper line
when reporting plugging
off formations.

Give All Information Completely
Make Required Affidavit
Mail or Deliver Report to:
Conservation Division
State Corporation Commission
800 Bitting Building
Wichita, Kansas

Graham County. Sec. 33 Twp. 7 Rge. 22 (E) (W)
Location as "NE 1/4 NW 1/4 SW 1/4" or footage from lines. SE 1/4 SE 1/4 NW 1/4
Lease Owner. D. G. Hansen
Lease Name. Morphew Well No. 1
Office Address. Logan, Kansas
Character of Well (completed as Oil, Gas or Dry Hole). Dry Hole
Date well completed. October 8 19 52
Application for plugging filed. October 8 19 52
Application for plugging approved. October 8 19 52
Plugging commenced. October 8 19 52
Plugging completed. October 8 19 52
Reason for abandonment of well or producing formation
Too low and tight structurally
If a producing well is abandoned, date of last production. 19
Was permission obtained from the Conservation Division or its agents before plugging was commenced? Yes

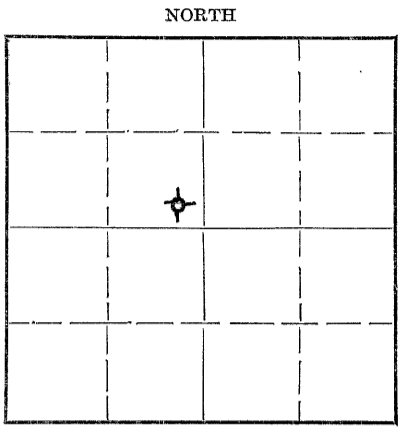

Locate well correctly on above
Section Plat

Name of Conservation Agent who supervised plugging of this well. Eldon Petty, Hays, Kansas
Producing formation. Depth to top. Bottom. Total Depth of Well. 3789 Feet
Show depth and thickness of all water, oil and gas formations.

OIL, GAS OR WATER RECORDS

CASING RECORD

Formation	Content	From	To	Size	Put In	Pulled Out
				8 5/8"	152.73	None
				5 1/2"	3788	None

Describe in detail the manner in which the well was plugged, indicating where the mud fluid was placed and the method or methods used in introducing it into the hole. If cement or other plugs were used, state the character of same and depth placed, from feet to feet for each plug set.

Filed hole with mud to within 300' of top and then
filled remainder of hole with 50 sacks cement.

10/17/52
RECEIVED
OCT 17 1952
CONSERVATION DIVISION
Wichita, Kansas

Correspondence regarding this well should be addressed to D. G. Hansen
Address. Logan, Kansas

STATE OF Kansas, COUNTY OF Phillips, ss.
D. G. Hansen (owner or operator) of the above-described well,
being first duly sworn on oath, says: That I have knowledge of the facts, statements, and matters herein contained and the log of the above-described well as filed and that the same are true and correct. So help me God.

(Signature) [Signature]
Logan, Kansas (Address)

SUBSCRIBED AND SWORN TO before me this 15th day of October 19 52

My commission expires 7/11/56 [Signature] Notary Public.

PLUGGING
FILE SEC 33 T 2 R 22
BOOK PAGE 57 LINE 8

CONTRACTOR'S WELL LOG

OPERATOR D. G. HANSEN FARM NAME MORPHEW #1
 LOCATION SE SE NW Sec. 33-7S-22W
 POOL NAME Wildcat COUNTY Graham STATE Kansas
 COMMENCEMENT DATE August 6, 1952 COMPLETION DATE August 17, 1952

LOG OF WELL

Elevation: 2213 R. B.
 All measurements from the top of rotary bushing.

FROM	TO	FORMATION	DEVIATION FROM VERTICAL	REMARKS:
0	153			
153	775	Shale-Shells-Sand		
775	835	Sand		
835	1015	Shale-Shells		
1015	1220	Sand-Shale		
1220	1235	Red Bed-Shale		
1235	1340	Red Bed-Shale		
1340	1550	Sand	0° - 1500'	
1550	1790	Red Bed		
1790	1803	Red Bed		
1803	1840	Anhydrite		
1840	2040	Shale	0° - 2000'	
2040	2185	Lime-Shale		
2185	2350	Lime-Shale		
2350	2530	Shale	0° - 2500'	
2530	2645	Lime-Shale		
2645	2780	Lime-Shale		
2780	2865	Lime-Shale		
2865	2935	Lime-Shale		
2935	3035	Lime-Shale	0° - 3000'	
3035	3135	Lime-Shale		
3135	3215	Lime-Shale		
3215	3295	Lime-Shale		
3295	3375	Lime-Shale		
3375	3440	Lime-Shale		
3440	3480	Lime-Shale		
3480	3497	Lime-Shale		DST 3480 - 3497
3497	3535	Lime	0° - 3500'	DST 3526 - 3535
3535	3545	Lime		
3545	3595	Lime		
3595	3622	Lime		DST 3604 - 3622
3622	3645	Lime		DST 3630 - 3645
3645	3660	Lime		
3660	3735	Lime-Shale		
3735	3770	Lime-Shale		
3770	3789	Lime		

CASING LEFT IN HOLE AFTER COMPLETION

Ran 152.73' (5 jts) 8 5/8" OD Casing.
 Set 3808.27' (88 jts.) 5 1/2" OD Casing

RECEIVED
 AUG 20 1952

D. G. Hansen, Contractor
 By _____

STATE OF KANSAS, COUNTY OF SEDGWICK) ss.

The undersigned certifies that to the best of her knowledge and belief, the above facts are true and correct.

PLUGGING
 FILE NO. 3317-R-221
 BOOK PAGE 57 LINE 8

C-G DRILLING CO.

By Wicky Trip
Marilyn Schmidt
 Notary Public

Subscribed and sworn to before me this 19th day of August 1952.

My commission expires: 11 - 21 - 55