

STATE OF KANSAS  
STATE CORPORATION COMMISSION

WELL PLUGGING RECORD

Give All Information Completely  
Make Required Affidavit  
Mail or Deliver Report to  
Conservation Division  
State Corporation Comm.  
245 North Water  
Wichita, KS 67202

Graham County, Sec. 36 Twp. 7S Rge. 22W E/W  
Location as "NE/CNW/SW" or footage from lines  
SE SE SE


Lease Owner Arrowhead Petroleum, Inc.  
Lease Name Legere Well No. #1  
Office Address P.O. Box 8287-Munger Station, Wichita, Ks.  
Character of Well (Completed as Oil, Gas or Dry Hole)  
Dry Hole

Date Well completed May 2, 1981 19  
Application for plugging filed May 2, 1981 19  
Application for plugging approved May 2, 1981 19  
Plugging commenced May 2, 1981 19  
Plugging completed May 2, 1981 19  
Reason for abandonment of well or producing formation  
Dry Hole

If a producing well is abandoned, date of last production  
N/A 19

Was permission obtained from the Conservation Division or  
its agents before plugging was commenced? Yes

Name of Conservation Agent who supervised plugging of this well Gil Balthazar  
Producing formation \_\_\_\_\_ Depth to top \_\_\_\_\_ Bottom \_\_\_\_\_ Total Depth of Well 3630  
Show depth and thickness of all water, oil and gas formations.

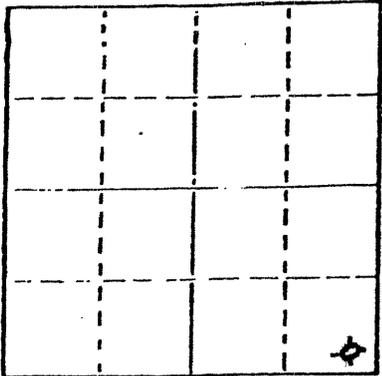

Locate well correctly on above  
Section List

OIL, GAS OR WATER RECORDS

CASING RECORD

FORMATION	CONTENT	FROM	TO	SIZE	PUT IN	PULLED OUT
Sand				8 5/8"	249'	none

Describe in detail the manner in which the well was plugged, indicating where the mud fluid was placed and the method or methods used in introducing it into the hold. If cement or other plugs were used, state the character of same and depth placed, from \_\_\_\_\_ feet to \_\_\_\_\_ feet for each plug set.

60 SX	850'
30 SX	280'
10 SX	40"
5 SX	RH
50 - 50 PAZ	6% gel

(If additional description is necessary, use BACK of this sheet)

Name of Plugging Contractor \_\_\_\_\_ Service Company \_\_\_\_\_ 5/7/81

STATE OF Kansas COUNTY OF Sedgwick, ss.  
Paul A. Seymour, Jr. (employee of owner) or (owner or operator)


of the above-described well, being first duly sworn on oath, says: That I have knowledge of the facts, statements, and matters herein contained and the log of the above-described well as filed and that the same are true and correct. So help me God.

(Signature) Paul A. Seymour, Jr.  
Paul A. Seymour, Jr. - BOX 8287-Munger Station  
(Address) Wichita, Ks. 67208

SUBSCRIBED AND SWORN TO before me this 6th day of May, 1981

LaDonna F. Landrum  
LaDonna F. Landrum Notary Public.

My commission expires August 18, 1984

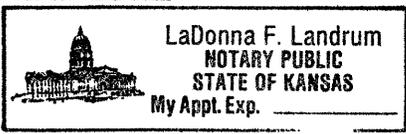

15-065-21383-00-00

# BIG SPRINGS DRILLING, INC.

P.O. BOX 8287  
MUNGER STATION  
WICHITA, KANSAS 67208

SUITE 29 • 400 NORTH WOODLAWN • (316) 681-1732

May 6, 1981

## DRILLERS LOG

Re: Legere #1  
SE SE SE  
Sec. 36 Twp 7S Rg 22W  
Graham County, Kansas

OPERATOR: Arrowhead Petroleum, Inc.  
CONTRACTOR: Big Springs Drilling, Inc.  
COMMENCED: April 26, 1981  
COMPLETED: May 2, 1981

Surface Pipe: 249' of 8 5/8" w/175 SX Common 2% gel 3% cc1

0	255'	Surface Clay & Shale
255'	1692'	Shale & Sand
1692'	1724'	Anhydrite
1724'	1727'	Shale
1727'	3428'	Shale & Lime
3428'	3511'	Lime
3511'	3617'	Lime & Shale
3617'	3630'	Shale & Lime
3630'		RTD

We certify that the above and foregoing is a true and correct copy of the log on the Legere #1 located in Graham County, Kansas.

Big Springs Drilling, Inc.


  
Paul A. Seymour, Jr.

Subscribed and sworn to before me this 6th day of May, 1981.

My Commission Expires:

August 18, 1984

  
LaDonna F. Landrum Notary Public

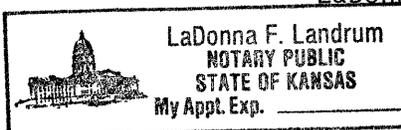

5/7/81