


STATE OF KANSAS
STATE CORPORATION COMMISSION

Give All Information Completely
Make Required Affidavit
Mail or Deliver Report to:
Conservation Division
State Corporation Commission
800 Bitting Building
Wichita, Kansas

WELL PLUGGING RECORD

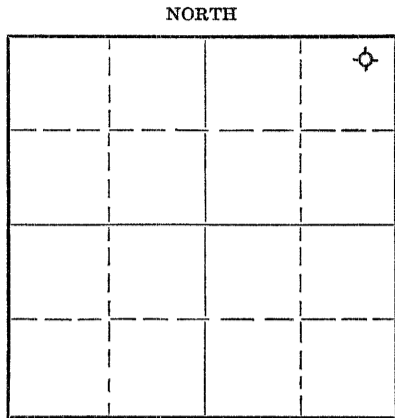

Locate well correctly on above
Section Plat

GRAHAM County. Sec. 34 Twp. 7S Rge. 22 (E) W (W)
Location as "NE/CNW 1/4 SW 1/4" or footage from lines NE NE NE
Lease Owner D. G. HANSEN
Lease Name JONES Well No. 1
Office Address Logan, Kansas
Character of Well (completed as Oil, Gas or Dry Hole) Dry Hole
Date well completed August 29, 19 52
Application for plugging filed August 29, 19 52
Application for plugging approved August 29, 19 52
Plugging commenced August 29, 19 52
Plugging completed August 29, 19 52
Reason for abandonment of well or producing formation too low structurally

If a producing well is abandoned, date of last production ----- 19-----
Was permission obtained from the Conservation Division or its agents before plugging was commenced? Yes

Name of Conservation Agent who supervised plugging of this well Eldon Petty, Hays, Kansas
Producing formation ----- Depth to top ----- Bottom ----- Total Depth of Well ----- Feet
Show depth and thickness of all water, oil and gas formations.

OIL, GAS OR WATER RECORDS

CASING RECORD

Formation	Content	From	To	Size	Put In	Pulled Out
				8 5/8"	156.13'	

Describe in detail the manner in which the well was plugged, indicating where the mud fluid was placed and the method or methods used in introducing it into the hole. If cement or other plugs were used, state the character of same and depth placed, from ----- feet to ----- feet for each plug set.

Filled hole with mud to 151'; set plug; 15 sacks cement, 1/2 sack hulls. Filled hole with mud to 40'; set plug then filled to top with 10 sacks cement and 1/2 sack hulls.

9/3/52

(If additional description is necessary, use BACK of this sheet)
Name of Plugging Contractor C-G DRILLING CO.
Address 206 Union National Bank Bldg., Wichita, Kansas.

STATE OF KANSAS, COUNTY OF SEDGWICK, ss.
G. F. GALLOWAY (employee of owner) or (owner or operator) of the above-described well, being first duly sworn on oath, says: That I have knowledge of the facts, statements, and matters herein contained and the log of the above-described well as filed and that the same are true and correct. So help me God.

(Signature) [Signature]
Union Nat'l Bank Bldg., Wichita, Kansas
(Address)

SUBSCRIBED AND SWORN to before me this 2nd day of September, 1952.

My commission expires November 21, 1955
Marilyn Schmidt
Notary Public.

39 7 220
46 29

CONTRACTOR'S WELL LOG

OPERATOR D. G. HANSEN FARM NAME JONES #1
 LOCATION NE NE NE Sec. 34-7S-22W
 POOL NAME Wildcat COUNTY Graham STATE Kansas
 COMMENCEMENT DATE August 18, 1952 COMPLETION DATE August 29, 1952

LOG OF WELL

Elevation: 2171' R. B.
 All measurements from the top of rotary bushing.

FROM	TO	FORMATION	DEVIATION FROM VERTICAL	REMARKS:
0	156			
156	630	Shale-Shells-Sand		
630	1080	Shale-Sand		
1080	1270	Shale		
1270	1480	Sand		
1480	1510	Shale	0° - 1500'	
1510	1745	Sand-Shale		
1745	1784	Anhydrite		
1784	1885	Shale		
1885	2065	Shale	0° - 2000'	
2065	2255	Lime-Shale		
2255	2400	Shale		
2400	2525	Lime-Shale	0° - 2500'	
2525	2670	Lime-Shale		
2670	2745	Lime-Shale		
2745	2835	Lime-Shale		
2835	2910	Lime-Shale		
2910	2980	Lime-Shale		
2980	3045	Lime-Shale	0° - 3000'	
3045	3140	Lime-Shale		
3140	3250	Lime-Shale		
3250	3315	Lime-Shale		
3315	3370	Lime-Shale		
3370	3405	Lime-Shale		
3405	3450	Lime		
3450	3480	Lime		
3480	3520	Lime	0° - 3500'	
3520	3570	Lime		
3570	3610	Lime		
3610	3660	Conglomerate		
3660	3690	Lime-Shale		
3690	3730	Lime-Shale		
3730	3763	Lime-Shale		


2/3/52

CASING LEFT IN HOLE AFTER COMPLETION

Ran 156.13' (5 jts.) 8 5/8" Casing.

STATE OF KANSAS, COUNTY OF SEDGWICK) ss.

The undersigned certifies that to the best of his knowledge and belief, the above facts are true and correct.

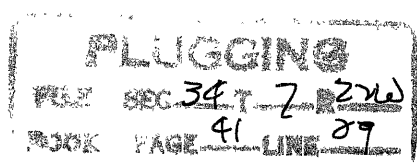

C-G DRILLING CO.
 By G. F. Galloway
 G. F. Galloway

Subscribed and sworn to before me this 2nd day of September, 1952.

My commission expires: November 21, 1955

Marilyn Schmidt
 Notary Public