

CARD MUST BE TYPED

State of Kansas
NOTICE OF INTENTION TO DRILL
(see rules on reverse side)

CARD MUST BE SIGNED

Starting Date: 12.....21.....1984.....
month day year
12 21 1984

OPERATOR: License # 5666
Name Petroleum Production Corp.
Address Box 202
City/State/Zip Paola, Kansas 66071
Contact Person Fred Green
Phone 913 878 3437

CONTRACTOR: License # 5666
Name Finchs Drilling Co
City/State R1, Box 125, Paola, Ks 66071

Well Drilled For: Well Class: Type Equipment:
 Oil Swd Infield Mud Rotary
 Gas Inj Pool Ext. Air Rotary
 OWWO Expl Wildcat Cable

If OWWO: old well info as follows:

Operator
Well Name
Comp Date Old Total Depth
Projected Total Depth 950 feet
Projected Formation at TD Mississippian
Expected Producing Formations

I certify that we will comply with K.S.A. 55-101, et seq., plus eventually plugging hole to K.C.C. specifications.

Date 12/20/84 Signature of Operator or Agent *Elaine Parkman* Title as agent

mhc/mohe 12/19/84 Form C-1 4/84

API Number 15-

121-26-464-00-00
 East
SE/4 ... Sec 12 Twp 17 S, Rge 22 ... West
(location)

1980 Ft North from Southeast Corner of Section
2310 Ft West from Southeast Corner of Section
(Note: Locate well on Section Plat on reverse side)

Nearest lease or unit boundary line 330 feet.
County Miami

Lease Name Woodman Well# 1

Domestic well within 330 feet: yes no

Municipal well within one mile: yes no

Depth to Bottom of fresh water 20 feet

Lowest usable water formation

Depth to Bottom of usable water 200 feet

Surface pipe by Alternate: 1 2

Surface pipe to be set 20 feet

Conductor pipe if any required


Ground surface elevation feet MSL

This Authorization Expires 6-20-85

Approved By 12-20-84 *Elaine Parkman*

Must be filed with the K.C.C. five (5) days prior to commencing well
This card void if drilling not started within six (6) months of date received by K.C.C.
CONSERVATION DIVISION

DEC 20 1984
12-20-84
STATE CORPORATION COMMISSIONER
A Regular Section of Land
1 Mile = 5,280 Ft.

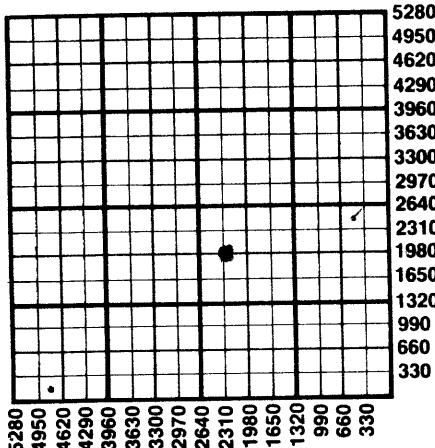

Important procedures to follow:

1. Notify District office before setting surface casing.
2. Set surface casing by circulating cement to the top.
3. File completion forms ACO-1 with K.C.C. within 90 days of well completion, following instructions on ACO-1, side 1, and including copies of wireline logs.
4. Notify District office 48 hours prior to old well workover or re-entry.
5. Prior to plugging, prepare a plugging plan, then obtain agreement from the appropriate district office for an approved plugging plan.
6. Submit plugging report (CP-4) to K.C.C. after plugging is completed.
7. Obtain an approved injection docket number before disposing of salt water.
8. Notify K.C.C. within 10 days when injection commences or terminates.
9. If an alternate 2 completion, cement in the production pipe from below any usable water to surface within 120 days of spud date.

State Corporation Commission of Kansas
Conservation Division
200 Colorado Derby Building
Wichita, Kansas 67202
(316) 263-3238