

CARD MUST BE TYPED

State of Kansas

CARD MUST BE SIGNED

NOTICE OF INTENTION TO DRILL

(see rules on reverse side)

Expected Spud Date..... 11/07/88
month day year

API Number 15- 121-26,948-00-00 ✓

OPERATOR: License # 4441

SE NE NW Sec. 06 Twp. 17 S, Rg. 22 XX East

Name REUSCH WELL SERVICE

4280 Ft. from South Line of Section

Address SUITE 11, 401 S. MAIN

3155 Ft. from East Line of Section

City/State/Zip OTTAWA 66067

(Note: Locate well on Section Plat on reverse side)

Contact Person ROBERT REUSCH

Nearest lease or unit boundary line 185 feet

Phone (913) 242-5733

County MIAMI

CONTRACTOR: License # 4441

Lease Name GLOVER Well # 6

Name REUSCH WELL SERVICE

Ground surface elevation APR 900 feet MSL

City/State OTTAWA 66067

Well Drilled For: Well Class: Type Equipment:

Domestic well within 330 feet: ___yes XXno

XX Oil ___ Storage XX Infield XX Mud Rotary

Municipal well within one mile: ___yes XXno

___ Gas ___ Inj ___ Pool Ext. ___ Air Rotary

Depth to bottom of fresh water 40 70'

___ OWWO ___ Expl ___ Wildcat ___ Cable

Depth to bottom of usable water 200

If OWWO: old well info as follows:

Surface pipe by Alternate: 1 ___ 2 XX

Operator

Surface pipe planned to be set 20

Well Name

Conductor pipe required *****

Comp Date..... Old Total Depth.....

Projected Total Depth 700 feet

Formation SQUIRREL

I certify that well will comply with K.S.A. 55-101, et seq., plus eventually plugging hole to KCC specifications.

Date 11/04/88.. Signature of Operator or Agent *[Signature]* Title AS AGENT

For KCC Use:

Conductor Pipe Required .. feet; Minimum Surface Pipe Required 20' feet per Alt. XX (2)

This Authorization Expires 5-4-89 Approved By LKM 11-4-88


EFFECTIVE DATE: 11-9-88

Must be filed with the K.C.C. five (5) days prior to commencing well
 This card void if drilling not started within six (6) months of date received by K.C.C.

Important procedures to follow:

1. Notify District office before setting surface casing.
2. Set surface casing by circulating cement to the top.
3. File completion forms ACO-1 with K.C.C. within 120 days of well spud date, following instructions on ACO-1, side 1, and including copies of wireline logs.
4. Notify District office 48 hours prior to old well workover or re-entry.
5. Prior to filing Intent, prepare a proposed plugging plan in case well is D & A, then obtain approval of plan when calling district office prior to setting surface pipe.
6. Submit plugging report (CP-4) to K.C.C. after plugging is completed.
7. Obtain an approved injection docket number before disposing of salt water.
8. Notify K.C.C. within 10 days when injection commences or terminates.
9. If an alternate 2 completion, cement in the production pipe from below any usable water to surface within 120 days of spud date.

**A Regular Section of Land
 1 Mile = 5,280 Ft.**

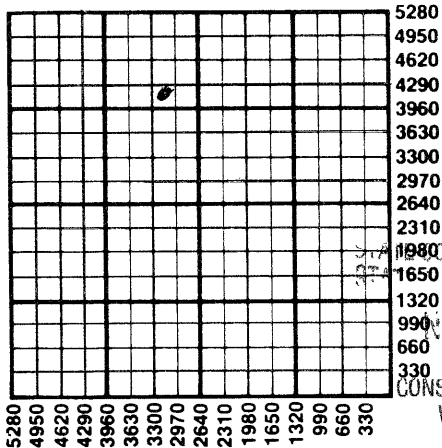

RECEIVED
 STATE CORPORATION COMMISSION
 NOV 4 1988
 11-04-88
 CONSERVATION DIVISION
 WICHITA, KANSAS

State Corporation Commission of Kansas
 Conservation Division
 200 Colorado Derby Building
 Wichita, Kansas 67202-1212
 (316) 263-3238