

CARD MUST BE TYPED

* CORRECTION

State of Kansas

CARD MUST BE SIGNED

NOTICE OF INTENTION TO DRILL

(see rules on reverse side)

CORRECTEDExpected Spud Date. 10/27/88
month day year

OPERATOR: License # 4441
 Name REUSCH WELL SERVICE, INC.
 Address Suite 11, 401 S. Main
 City/State/Zip Ottawa, Kansas 66067
 Contact Person Robert Reusch
 Phone (913)242-5733

CONTRACTOR: License # 4441
 Name REUSCH WELL SERVICE, INC.
 City/State Ottawa, Kansas 66067

Well Drilled For: Well Class: Type Equipment:
☒ Oil ☐ Storage ☒ Infield ☒ Mud Rotary
☐ Gas ☐ Inj ☐ Pool Ext. ☐ Air Rotary
☐ OWWO ☐ Expl ☐ Wildcat ☐ Cable

If OWWO: old well info as follows:

Operator
 Well Name
 Comp Date Old Total Depth

I certify that well will comply with K.S.A. 55-101, et seq., plus eventually plugging hole to KCC specifications.

Date 10/25/88 Signature of Operator or Agent E. Reusch Title Operator

For KCC Use:

Conductor Pipe Required feet; Minimum Surface Pipe Required 20' feet per Alt. X (2)This Authorization Expires 4-25-89 Approved By LKM 11-14-88 Date Rec'd: 10-25-88EFFECTIVE DATE: 10-30-88

API Number 15— 121-26,944 - 00-00
 * SW NE NW Sec. 06 Twp. 17 S, Rg. 22 X East
4280 West
 * 3415 Ft. from South Line of Section
 Ft. from East Line of Section

(Note: Locate well on Section Plat on reverse side)

Nearest lease or unit boundary line 165 feet
 County Miami
 Lease Name Glover Well # 5
 Ground surface elevation Appx. 900 feet MSL
 Domestic well within 330 feet: ☐ yes ☒ no
 Municipal well within one mile: ☐ yes ☒ no
 Depth to bottom of fresh water 40
 Depth to bottom of usable water 200
 Surface pipe by Alternate: 1 2 X
 Surface pipe planned to be set 20
 Conductor pipe required *****
 Projected Total Depth 700 feet
 Formation Squirrel Sand

* WAS: SE NE NW, 2805' FEL

Must be filed with the K.C.C. five (5) days prior to commencing well
This card void if drilling not started within six (6) months of date received by K.C.C.

Important procedures to follow:

1. Notify District office before setting surface casing.
2. Set surface casing by circulating cement to the top.
3. File completion forms ACO-1 with K.C.C. within 120 days of well spud date, following instructions on ACO-1, side 1, and including copies of wireline logs.
4. Notify District office 48 hours prior to old well workover or re-entry.
5. Prior to filing Intent, prepare a proposed plugging plan in case well is D & A, then obtain approval of plan when calling district office prior to setting surface pipe.


Submit plugging report (CP-4) to K.C.C. after plugging is completed.

7. Obtain an approved injection docket number before disposing of salt water.

8. Notify K.C.C. within 10 days when injection commences or terminates.

When alternate 2 completion, cement in the production pipe from below any usable water to surface within 120 days of spud date.

A Regular Section of Land 1 Mile = 5,280 Ft.

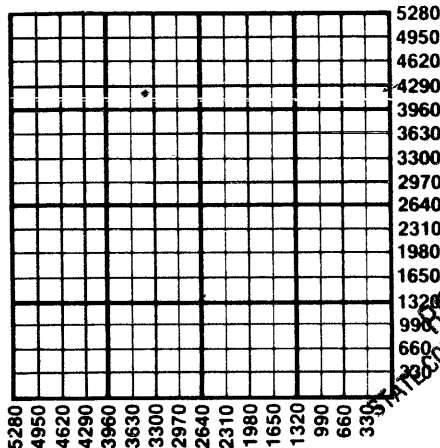

State Corporation Commission of Kansas
Conservation Division
200 Colorado Derby Building
Wichita, Kansas 67202-1212
(316) 263-3238