

CARD MUST BE TYPED

State of Kansas

CARD MUST BE SIGNED

NOTICE OF INTENTION TO DRILL

(see rules on reverse side)

Starting Date 12 19 1986
month day year 11:22

API Number 15— 121-26,786-00-00
E/2

OPERATOR: License # 4441 App C

..... NW/4. Sec. 6 Twp. 17 S, Rg. 22
X East
West

Name Reusch Well Service, Inc.

..... 3960 Ft. from South Line of Section

Address 401 S. Main, # 11
..... 3380 Ft. from East Line of Section

City/State/Zip Ottawa, KS. 66067
(Note: Locate well on Section Plat on reverse side)

Contact Person Liz Reusch
Nearest lease or unit boundary line 1320 feet

Phone 913-242-5733
County Miami
Lease Name Dig 6 Well # 6
Ground surface elevation na feet MSL

CONTRACTOR: License #
Name company tools
City/State
Well Drilled For: Well Class: Type Equipment:

Domestic well within 330 feet: —yes no

Municipal well within one mile: —yes no

X— Oil — SWD X— Infield —X Mud Rotary

Depth to bottom of fresh water 26

— Gas — Inj — Pool Ext. — Air Rotary

Depth to bottom of usable water 200

— OWWO — Expl — Wildcat — Cable

Surface pipe by Alternate: 1 — 2 X

If OWWO: old well info as follows:

Surface pipe planned to be set 20

Operator

Conductor pipe required

Well Name

Projected Total Depth 1000 feet

Comp Date Old Total Depth

Formation

I certify that well will comply with K.S.A. 55-101, et seq., plus eventually plugging hole to KCC specifications.

Date .. 12/18/86 Signature of Operator or Agent Elaine Dabman Title as agent

For KCC Use:

Conductor Pipe Required feet; Minimum Surface Pipe Required 20 feet per Alt. W2


This Authorization Expires 6-18-87 Approved By 12-18-86
John Mc

Must be filed with the K.C.C. five (5) days prior to commencing well
 This card void if drilling not started within six (6) months of date received by K.C.C.

Important procedures to follow:

1. Notify District office before setting surface casing.
2. Set surface casing by circulating cement to the top.
3. File completion forms ACO-1 with K.C.C. within 90 days of well completion, following instructions on ACO-1, side 1, and including copies of wireline logs.
4. Notify District office 48 hours prior to old well workover or re-entry.
5. Prior to filing Intent, prepare a proposed plugging plan in case well is D & A, then obtain approval of plan when calling district office prior to setting surface pipe.
6. Submit plugging report (CP-4) to K.C.C. after plugging is completed.
7. Obtain an approved injection docket number before disposing of salt water.
8. Notify K.C.C. within 10 days when injection commences or terminates.

A Regular Section of Land
1 Mile = 5,280 Ft.

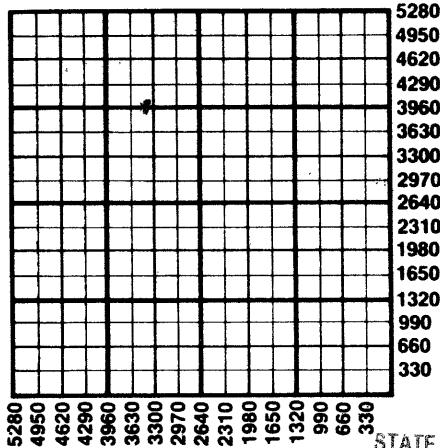

RECEIVED
 STATE CORPORATION COMMISSION

DEC 18 1986

CONSERVATION DIVISION
 Wichita, Kansas

9. If an alternate 2 completion, cement in the production pipe from below any usable water to surface within 120 days of spud date.

State Corporation Commission of Kansas
 Conservation Division
 200 Colorado Derby Building
 Wichita, Kansas 67202
 (316) 263-3238