

CARD MUST BE TYPED

State of Kansas
NOTICE OF INTENTION TO DRILL

CARD MUST BE SIGNED

(see rules on reverse side)

Starting Date: August 19, 1985
month day year

API Number 15- 065-22,224-00-00

OPERATOR: License # 5427
Name D. R. Lauck Oil Company, Inc.
Address 221 S. Broadway, Suite 400
City/State/Zip Wichita, Kansas 67202
Contact Person John D. Knightley, President
Phone (316) 263-8267

60' W of SW NE SE Sec. 35 Twp. 7S. S, Rge. 24W
(location) East West

1650 Ft North from Southeast Corner of Section
990 Ft West from Southeast Corner of Section
(Note: Locate well on Section Plat on reverse side)

CONTRACTOR: License # 5427
Name D. R. Lauck Oil Company, Inc.
City/State Wichita, Kansas

Nearest lease or unit boundary line 990 feet.
County Graham
Lease Name Rice Trust Well# 1

Well Drilled For: Well Class: Type Equipment:
 Oil Swd Infield Mud Rotary
 Gas Inj Pool Ext. Air Rotary
 OWWO Expl Wildcat Cable

Domestic well within 330 feet: yes no
Municipal well within one mile: yes no

If OWWO: old well info as follows:

Operator
Well Name
Comp Date Old Total Depth
Projected Total Depth 3960 feet
Projected Formation at TD L/K.C.
Expected Producing Formations L/K.C.

Depth to Bottom of fresh water 100 ~ 150 feet
Lowest usable water formation Dakota
Depth to Bottom of usable water 1300 feet
Surface pipe by Alternate: 1 2
Surface pipe to be set 250 feet
Conductor pipe if any required feet
Ground surface elevation 2440 feet MSL
This Authorization Expires 2-15-86
Approved By 8-15-85 RCH for KONE

I certify that we will comply with K.S.A. 55-101, et seq., plus eventually plugging hole to K.C.C. specifications.


Date 8/14/85 Signature of Operator or Agent John D. Knightley Title President

(Statement attached.)

**Must be filed with the K.C.C. five (5) days prior to commencing well
This card void if drilling not started within six (6) months of date received by K.C.C.**

Important procedures to follow :

**A Regular Section of Land
1 Mile = 5,280 Ft.**

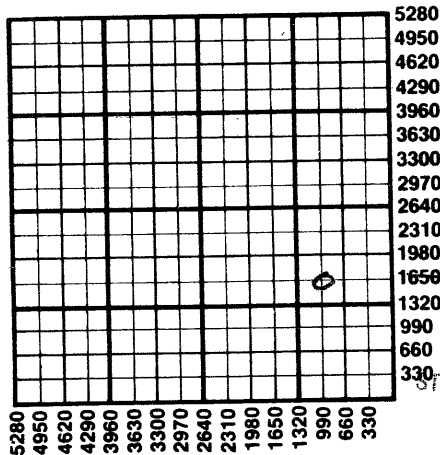

1. Notify District office before setting surface casing.
2. Set surface casing by circulating cement to the top.
3. File completion forms ACO-1 with K.C.C. within 90 days of well completion, following instructions on ACO-1, side 1, and including copies of wireline logs.
4. Notify District office 48 hours prior to old well workover or re-entry.
5. Prior to plugging, prepare a plugging plan, then obtain agreement from the appropriate district office for an approved plugging plan.
6. Submit plugging report (CP-4) to K.C.C. after plugging is completed.
7. Obtain an approved injection docket number before disposing of salt water.
8. Notify K.C.C. within 10 days when injection commences or terminates.
9. If an alternate 2 completion, cement in the production pipe from below any usable water to surface within 120 days of spud date.

RECEIVED
STATE CORPORATION COMMISSION

**State Corporation Commission of Kansas
Conservation Division
200 Colorado Derby Building
Wichita, Kansas 67202
(316) 263-3238**

AUG 15 1985
AUG 15 1985
CONSERVATION DIVISION
Wichita, Kansas