

CARD MUST BE TYPED

NOTICE OF INTENTION TO DRILL

State of Kansas
(see rules on reverse side)

CARD MUST BE SIGNED

Starting Date: 6 26 1985
month day year

API Number 15- 065-22,206-00-00

OPERATOR: License # 9449
Name ... Great Eastern Energy & Develop. Corp.
Address ... 5660 S. Syracuse Circle
City/State/Zip ... Englewood, CO 80111
Contact Person ... John W. Smith
Phone ... (303) 773-6016

SW NE SW 11 7 23 East
(location) Sec Twp S, Rge West
1650 Ft North from Southeast Corner of Section
3630 Ft West from Southeast Corner of Section
(Note: Locate well on Section Plat on reverse side)

CONTRACTOR: License # 8301
Name .. Stoepfelwerth Drilling, Inc.
City/State ... McCook, NE 69001

Nearest lease or unit boundary line ... 1650 feet.

County ... Graham

Lease Name ... Hale Well# 1

Domestic well within 330 feet : yes no

Municipal well within one mile : yes no

Well Drilled For: Well Class: Type Equipment:
 Oil Swd Infield Mud Rotary
 Gas Inj Pool Ext. Air Rotary
 OWWO Expl Wildcat Cable

Depth to Bottom of fresh water ... 90 ~~125~~ ^{in etc} feet

Lowest usable water formation ... Dakota

Depth to Bottom of usable water ... 1100 ~~1200~~ feet

Surface pipe by Alternate : 1 2

Surface pipe to be set ... 250 feet

Conductor pipe if any required ... feet

Ground surface elevation ... feet MSL

This Authorization Expires ... 12-19-85

Approved By ... 6-19-85 *PC*

I certify that we will comply with K.S.A. 55-101, et seq., plus eventually plugging hole to K.C.C. specifications.

Date 6/18/85 Signature of Operator or Agent


Susan Arnold Title

MHC/JOHE 6-19-85
As Agent

Must be filed with the K.C.C. five (5) days prior to commencing well
 This card void if drilling not started within six (6) months of date received by K.C.C.

Important procedures to follow :

**A Regular Section of Land
 1 Mile = 5,280 Ft.**

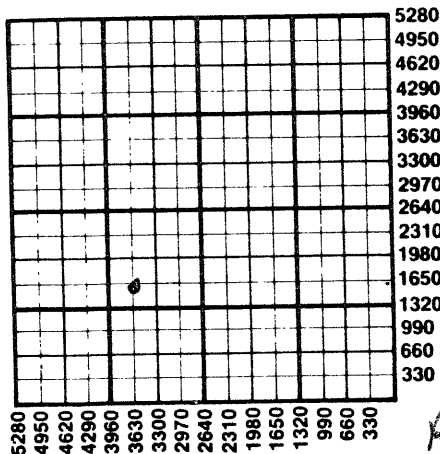

*Reed
 6-19-85*

1. Notify District office before setting surface casing.
2. Set surface casing by circulating cement to the top.
3. File completion forms ACO-1 with K.C.C. within 90 days of well completion, following instructions on ACO-1, side 1, and including copies of wireline logs.
4. Notify District office 48 hours prior to the well workover or re-entry.
5. Prior to plugging, prepare a plugging plan, then obtain agreement from the appropriate district office for an approved plugging plan.
6. Submit plugging report (CP-4) to K.C.C. after plugging is completed.
7. Obtain an approved injection order number before disposing of salt water.
8. Notify K.C.C. within 10 days when injection commences or terminates.
9. If an alternate 2 completion, cement in the production pipe from below any usable water to surface within 120 days of spud date.

RECEIVED
 STATE CORPORATION COMMISSION
 JUN 19 1985
 CONSERVATION DIVISION
 WICHITA, KANSAS

**State Corporation Commission of Kansas
 Conservation Division
 200 Colorado Derby Building
 Wichita, Kansas 67202
 (316) 263-3238**