

CARD MUST BE TYPED

State of Kansas

CARD MUST BE SIGNED

NOTICE OF INTENTION TO DRILL

(see rules on reverse side)

Starting Date January 26, 1987
month day year

API Number 15— 059-24,208-00-00

OPERATOR: License # 9873
Name Painter Oil Company, INC
Address Box 141 B, Route 2
City/State/Zip Wellsville, Kansas 66092
Contact Person Joe Smith
Phone 913.242.7310

App. SW SE SE... Sec. 20. Twp. 15 S, Rg. 20... ^X East
165 Ft. from South Line of Section
1155 Ft. from East Line of Section

(Note: Locate well on Section Plat on reverse side)

CONTRACTOR: License # 6807
Name Oil Drillers & Developers, Inc.
City/State Topeka, Kansas

Nearest lease or unit boundary line 165 feet
County Franklin

Well Drilled For: Well Class: Type Equipment:
 Oil SWD Infill Mud Rotary
 Gas Inj Pool Ext. Air Rotary
 OWWO Expl Wildcat Cable

Lease Name Leach B Well # 3
Ground surface elevation na feet MSL
Domestic well within 330 feet: yes no

If OWWO: old well info as follows:

Operator
Well Name
Comp Date Old Total Depth

Municipal well within one mile: yes no
Depth to bottom of fresh water 60
Depth to bottom of usable water 200
Surface pipe by Alternate: 1 2X
Surface pipe planned to be set 40
Conductor pipe required
Projected Total Depth 760 feet
Formation

I certify that well will comply with K.S.A. 55-101, et seq., plus eventually plugging hole to KCC specifications.

Date ... 1/21/87 Signature of Operator or Agent *Celain Parkman* Title as agent

For KCC Use:

Conductor Pipe Required feet; Minimum Surface Pipe Required 20 feet per A10 9 ②
This Authorization Expires 7-21-87 Approved By 1-21-87 *[Signature]*


[Signature]

Must be filed with the K.C.C. five (5) days prior to commencing well
This card void if drilling not started within six (6) months of date received by K.C.C.

Important procedures to follow:

1. Notify District office before setting surface casing.
2. Set surface casing by circulating cement to the top.
3. File completion forms ACO-1 with K.C.C. within 90 days of well completion, following instructions on ACO-1, side 1, and including copies of wireline logs.
4. Notify District office 48 hours prior to old well workover or re-entry.
5. Prior to filing Intent, prepare a proposed plugging plan in case well is D & A, then obtain approval of plan when calling district office prior to setting surface pipe.
6. Submit plugging report (CP-4) to K.C.C. after plugging is completed.
7. Obtain an approved injection docket number before disposing of salt water.
8. Notify K.C.C. within 10 days when injection commences or terminates.

**A Regular Section of Land
1 Mile = 5,280 Ft.**

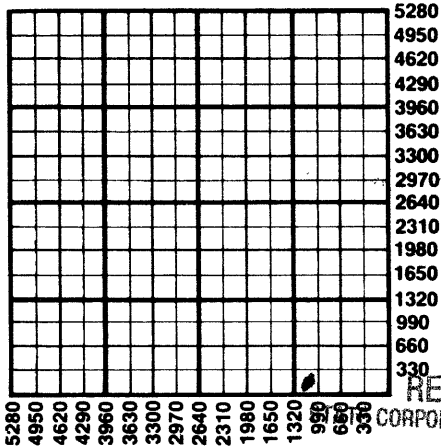

RECEIVED

CORPORATION COMMISSION

of an alternate 2 completion, cement in the production pipe from below any usable water to surface within 120 days of spud date.

JAN 21 1987

1-21-87
CONSERVATION DIVISION
Wichita, Kansas

State Corporation Commission of Kansas
Conservation Division
200 Colorado Derby Building
Wichita, Kansas 67202
(316) 263-3238