

CARD MUST BE TYPED

State of Kansas

CARD MUST BE SIGNED

NOTICE OF INTENTION TO DRILL

(see rules on reverse side)

Starting Date January 26, 1987 month day year

API Number 15- 059-24,209-00-00

OPERATOR: License # 9873 Name Painter Oil Company, Inc. Address Box 141 B, Route 2 City/State/Zip Wellsville, Kansas 66092 Contact Person Joe Smith Phone 913.242.7310

App. SW SE SE Sec. 20 Twp. 15 S, Rg. 20 East West

165 Ft. from South Line of Section 825 Ft. from East Line of Section

(Note: Locate well on Section Plat on reverse side)

CONTRACTOR: License # 6807 Name Oil Drillers & Developers, Inc. City/State Topeka, Kansas

Nearest lease or unit boundary line 165 feet County Franklin

Lease Name Leach B Well # 2

Ground surface elevation na feet MSL

Well Drilled For: Well Class: Type Equipment: Oil SWD Infield Mud Rotary Gas Inj Pool Ext Air Rotary OWWO Expl Wildcat Cable

Domestic well within 330 feet: yes no

Municipal well within one mile: yes no

Depth to bottom of fresh water 60

Depth to bottom of usable water 200

Surface pipe by Alternate: 1 2 X

If OWWO: old well info as follows: Operator Well Name Comp Date Old Total Depth

Surface pipe planned to be set 40

Conductor pipe required

Projected Total Depth 760 feet

Formation

I certify that well will comply with K.S.A. 55-101, et seq., plus eventually plugging hole to KCC specifications.

Date 1/21/87 Signature of Operator or Agent Elaine Barkham Title as agent

For KCC Use:

Conductor Pipe Required feet; Minimum Surface Pipe Required 20 feet per Alt. P 2

This Authorization Expires 7-21-87 Approved By 1-21-87


Signature

Must be filed with the K.C.C. five (5) days prior to commencing well  
 This card void if drilling not started within six (6) months of date received by K.C.C.

**Important procedures to follow:**

1. Notify District office before setting surface casing.
2. Set surface casing by circulating cement to the top.
3. File completion forms ACO-1 with K.C.C. within 90 days of well completion, following instructions on ACO-1, side 1, and including copies of wireline logs.
4. Notify District office 48 hours prior to old well workover or re-entry.
5. Prior to filing Intent, prepare a proposed plugging plan in case well is D & A, then obtain approval of plan when calling district office prior to setting surface pipe.
6. Submit plugging report (CP-4) to K.C.C. after plugging is completed.
7. Obtain an approved injection docket number before disposing of salt water.
8. Notify K.C.C. within 10 days when injection commences or terminates.
9. If an alternate 2 completion, cement in the production pipe from below any usable water to surface within 120 days of spud date.

**A Regular Section of Land**  
**1 Mile = 5,280 Ft.**

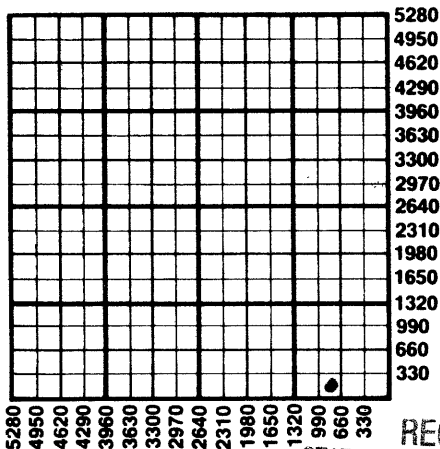

RECEIVED  
 STATE CORPORATION COMMISSION

1-21-87  
 JAN 21 1987

CONSERVATION DIVISION  
 Wichita, Kansas

State Corporation Commission of Kansas  
 Conservation Division  
 200 Colorado Derby Building  
 Wichita, Kansas 67202  
 (316) 263-3238