


STATE OF KANSAS  
STATE CORPORATION COMMISSION

Give All Information Completely  
Make Required Affidavit  
Mail or Deliver Report to:  
Conservation Division  
State Corporation Commission  
212 North Market, Insurance Bldg.  
Wichita, Kansas

15-065-00664-00-00

WELL PLUGGING RECORD

NORTH

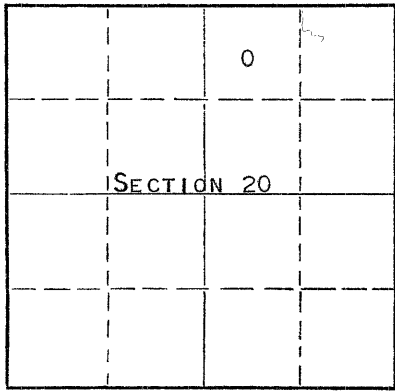

Locate well correctly on above  
Section Plat

GRAHAM County. Sec. 20 Twp. 7s Rge. 24w (#) (W)  
Location as "NE/CNW/SW" or footage from lines C NW NE  
Lease Owner PETROLEUM, INC.  
Lease Name MOORE "D" Well No. 1  
Office Address ROUTE 2, GREAT BEND, KANSAS  
Character of Well (completed as Oil, Gas or Dry Hole) DRY HOLE  
Date well completed MARCH 30 1961  
Application for plugging filed MARCH 30 1961  
Application for plugging approved MARCH 30 1961  
Plugging commenced MARCH 30 19 61  
Plugging completed MARCH 31 19 61  
Reason for abandonment of well or producing formation  
NO PRODUCIBLE ZONES  
If a producing well is abandoned, date of last production NONE 19  
Was permission obtained from the Conservation Division or its agents before plugging was commenced? YES

Name of Conservation Agent who supervised plugging of this well MR. A. D. FABRICIUS  
Producing formation \_\_\_\_\_ Depth to top \_\_\_\_\_ Bottom \_\_\_\_\_ Total Depth of Well 3894 Feet  
Show depth and thickness of all water, oil and gas formations.

OIL, GAS OR WATER RECORDS

CASING RECORD

FORMATION	CONTENT	FROM	TO	SIZE	PUT IN	PULLED OUT
				8-5/8"	253'	NONE

Describe in detail the manner in which the well was plugged, indicating where the mud fluid was placed and the method or methods used in introducing it into the hole. If cement or other plugs were used, state the character of same and depth placed, from \_\_\_\_\_ feet to \_\_\_\_\_ feet for each plug set.

MUDDED UP WITH HEAVY MUD TO 400' FOLLOWED BY WOODEN PLUG AND 1/4 SACK HULLS. PLACED 20 SACKS CEMENT THROUGH DRILL PIPE ON TO HULLS. MUDDED UP WITH HEAVY MUD TO 250' FOLLOWED BY WOODEN PLUG AND 1/4 SACK HULLS. PLACED 20 SACKS CEMENT THROUGH DRILL PIPE ON TO HULLS. MUDDED UP WITH HEAVY MUD TO 40' FOLLOWED BY WOODEN PLUG AND 1/4 SACK HULLS. PLACED 10 SACKS CEMENT ON TO HULLS TO BASE OF WELL CELLAR.

RECEIVED  
STATE CORPORATION COMMISSION

APR 20 1961

CONSERVATION DIVISION  
Wichita, Kansas

(If additional description is necessary, use BACK of this sheet)  
Name of Plugging Contractor GARVEY DRILLING COMPANY  
Address ROUTE 2, GREAT BEND, KANSAS

STATE OF KANSAS, COUNTY OF BARTON, ss.  
PETROLEUM, INC. (employee of owner) or ( ) of the above-described well, being first duly sworn on oath, says: That I have knowledge of the facts, statements, and matters herein contained and the log of the above-described well as filed and that the same are true and correct. So help me God.

(Signature) Dow Searle  
ROUTE 2, GREAT BEND, KANSAS  
(Address)

SUBSCRIBED AND SWORN to before me this 17TH day of APRIL, 19 61

My commission expires APRIL 14, 1963  
Arthur J. Nile Notary Public.



# WELL LOG

15-065-00664-00-00

COMPANY PETROLEUM, INCORPORATED

SEC. 20 T. 7S R. 20W

FARM MOORE "D" NO. 1

LOC. C-NW, NE


TOTAL DEPTH 3984'

COUNTY GRAHAM CO., KANSAS

COMM. March 23, 1961

COMP. March 31, 1961

CONTRACTOR GARVEY DRILLING COMPANY

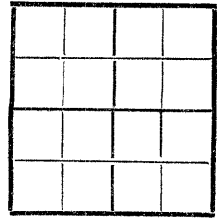

CASING 8 5/8" @ 253' w/175 sax.

ELEVATION 2496' DF

PRODUCTION D & A

FIGURES INDICATE BOTTOM OF FORMATIONS

40	Surface soil
193	Sand
253	Shale & shells
975	Shale
1760	Sand & shale
1970	Sand
2115	Shale & red bed
2190	Shale
2228	Anhydrite
2500	Shale & shells
2785	Shale
2960	Shale & lime
3150	Shale & shells
3410	Lime & shale
3650	Shale & lime
3735	Lime & shale
3984	Lime
3984	T. D.

**RECEIVED**  
STATE CORPORATION COMMISSION

APR 20 1961

CONSERVATION DIVISION  
Wichita, Kansas

4-20-61

State of KANSAS  
County of BARTON } ss

I, VERNE A. MORRIS of GARVEY DRILLING COMPANY

upon oath state the above and foregoing is a true and correct copy of the log of the #1 MOORE "D" well.

Verne A. Morris

Subscribed and sworn to before me this 14th day of April 19 61

My Commission Expires: April 14, 1963

Arthur J. Opiles  
NOTARY PUBLIC