


15-065-00331-00-00

STATE OF KANSAS
STATE CORPORATION COMMISSION

Give All Information Completely
Make Required Affidavit
Mail or Deliver Report to:
Conservation Division
State Corporation Commission
800 Bitting Building
Wichita, Kansas

WELL PLUGGING RECORD

NORTH

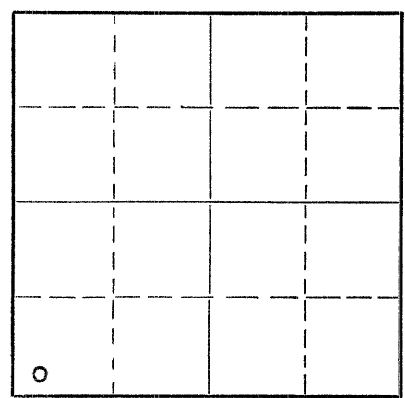

Locate well correctly on above
Section Plat

Graham County. Sec. 22 Twp. 7 Rge. 24 ~~W~~ W (W)
Location as "NE/CNW/SW" or footage from lines SW Cor.
Lease Owner Nadel and Gussman
Lease Name Paxton Well No. 1
Office Address P. O. Box 309, Tulsa, Oklahoma
Character of Well (completed as Oil, Gas or Dry Hole) Dry
Date well completed 12-15 19 52
Application for plugging filed 12-15 19 52
Application for plugging approved 12-15 19 52
Plugging commenced 12-15 19 52
Plugging completed 12-15 19 52
Reason for abandonment of well or producing formation Dry

If a producing well is abandoned, date of last production _____ 19____
Was permission obtained from the Conservation Division or its agents before plugging was commenced? Yes

Name of Conservation Agent who supervised plugging of this well Eldon Petty
Producing formation _____ Depth to top _____ Bottom _____ Total Depth of Well 4250 Feet
Show depth and thickness of all water, oil and gas formations.

OIL, GAS OR WATER RECORDS

CASING RECORD

FORMATION	CONTENT	FROM	TO	SIZE	PUT IN	PULLED OUT
				8-5/8"	163	0

Describe in detail the manner in which the well was plugged, indicating where the mud fluid was placed and the method or methods used in introducing it into the hole. If cement or other plugs were used, state the character of same and depth placed, from _____ feet to _____ feet for each plug set.

Hole filled with heavy mud from T.D. to 160' - Set plug at 155' and cemented with 15 sacks cement - mud to 40', set plug and cemented with ten sacks cement.

(If additional description is necessary, use BACK of this sheet)

Name of Plugging Contractor Reserve Drilling Company, Inc.
Address Wichita, Kansas

STATE OF KANSAS, COUNTY OF SEDGWICK, ss.
L. C. Hay (employee of owner) ~~of~~ of the above-described well, being first duly sworn on oath, says: That I have knowledge of the facts, statements, and matters herein contained and the log of the above-described well as filed and that the same are true and correct. So help me God.

(Signature) L. C. Hay
703 Union National Bank Bldg.
(Address)

SUBSCRIBED AND SWORN TO before me this 17th day of December, 19 52

My commission expires Nov. 3, 1956

24-2675-S 2-52-20M

PLUGGING
FILE SEC 227 7 R 24 W
BOOK PAGE 66 LINE 26

Notary Public.
STATE CORPORATION COMMISSION
DEC 22 1952 12-23-52
CONSERVATION DIVISION
Wichita, Kansas