

15-065-00822-00-00

STATE OF KANSAS
STATE CORPORATION COMMISSION

Give All Information Completely
Make Required Affidavit
Mail or Deliver Report to:
Conservation Division
State Corporation Commission
211 No. Broadway
Wichita, Kansas

WELL PLUGGING RECORD

Graham County, Sec. 20 Twp. 7S Rge. 24W (E) (W)X

Location as "NE/CNW/SW" or footage from lines SE SE SE

Lease Owner Burch Drilling Co., Inc.

Lease Name Goddard Well No. 1

Office Address 1011 Union Center, Wichita, Kansas

Character of Well (completed as Oil, Gas or Dry Hole) Dry Hole

Date well completed 3-19-59 19

Application for plugging filed 1-1-59 19

Application for plugging approved 3-19-59 19


Plugging commenced 3-19-59 19

Plugging completed 3-19-59 19

Reason for abandonment of well or producing formation Dry Hole

If a producing well is abandoned, date of last production _____ 19

Was permission obtained from the Conservation Division or its agents before plugging was commenced? yes

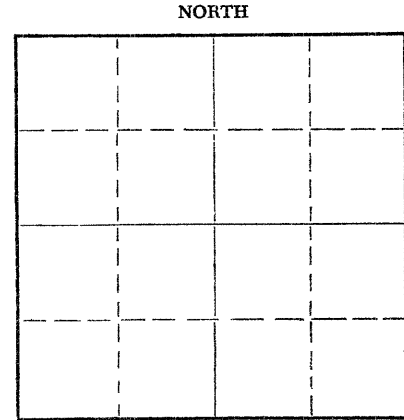

Locate well correctly on above
Section Plat

Name of Conservation Agent who supervised plugging of this well Fabricus

Producing formation _____ Depth to top _____ Bottom _____ Total Depth of Well 3923 Feet

Show depth and thickness of all water, oil and gas formations.

OIL, GAS OR WATER RECORDS

CASING RECORD

FORMATION	CONTENT	FROM	TO	SIZE	PUT IN	PULLED OUT

Describe in detail the manner in which the well was plugged, indicating where the mud fluid was placed and the method or methods used in introducing it into the hole. If cement or other plugs were used, state the character of same and depth placed, from _____ feet to _____ feet for each plug set.

1st plug set at 600' with 20 sacks cement
2nd plug set at 180' with 20 sacks cement
3rd plug set at 40' with 10 sacks cement

RECEIVED
STATE CORPORATION COMMISSION
APR 2 1959
CONSERVATION DIVISION
Wichita, Kansas

4-2-59

(If additional description is necessary, use BACK of this sheet)
Name of Plugging Contractor Burch Drilling Co., Inc.
Address 1011 Union Center, Wichita, Kansas

STATE OF KANSAS, COUNTY OF SEDGWICK, ss.
Earl M. Burch, President (Employee or owner) or (owner or operator) of the above-described

well, being first duly sworn on oath, says: That I have knowledge of the facts, statements, and matters herein contained and the log of the above-described well as filed and that the same are true and correct. So help me God.

(Signature) Earl M. Burch
1011 Union Center, Wichita, Kansas
(Address)

SUBSCRIBED AND SWORN TO before me this 1st day of April, 1959.

My commission expires July 27, 1960.
Ginny Harrison Notary Public.

PLUGGING
FILE SEC. 20 T. 7S R. 24W
BOOK PAGE 27 LINE 16

WELL LOG

Burch Drilling Co., Inc
1 Goddard SE SE SE
20-7S-24W, Graham County, Kansas

Elevation: 2433 Kelly bushing
8 5/8" casing set @ 195' w/225 sx.
Commenced: 3-12-59
Completed: 3-19-59
D & A

195 sand
930 Shale & Shells
1735 Shale
2150 Shale & Sand
2183 Anhydrite
2555 Shale & Lime streaks
3635 Lime & Shale
3700 Lime
3763 Lime & Shale
3983 Lime

3983 Rotary Total Depth

TOPS
Heebner 3708
Toronto 3735
Lansing 3752

No Testing.

RECEIVED
STATE CORPORATION COMMISSION

APR 2 1959

CONSERVATION DIVISION
Wichita, Kansas

4-2-59

STATE OF KANSAS, COUNTY OF SEDGWICK:

I, Earl M. Burch, President of Burch Drilling Co., Inc. being duly sworn on oath, state: That I have knowledge of the facts, statements, and matters herein contained and that the same are true and correct.

Earl M. Burch

Subscribed and sworn to before me this 1st day of April, 1959.

Genny Harrison
(Notary Public)

My Commission expires: July 27, 1960.

PLUGGING
FILE SEC. 20 T. 7 R. 24W
BOOK PAGE 27 LINE 16