


STATE OF KANSAS  
STATE CORPORATION COMMISSION

Give All Information Completely  
Make Required Affidavit  
Mail or Deliver Report to:  
Conservation Division  
State Corporation Commission  
212 North Market, Insurance Bldg.  
Wichita, Kansas

WELL PLUGGING RECORD

Graham County. Sec. 6 Twp. 7S Rge. XX 25 (W)

Location as "NE/CNW/SW" or footage from lines SE NE NE  
Lease Owner Peel-Hardman Oil Operators  
Lease Name Lindenman "B" Well No. 2  
Office Address R. R. #3, Box 144B, Wichita 20, Kansas  
Character of Well (completed as Oil, Gas or Dry Hole) Dry Hole  
Date well completed 6-9 19 60  
Application for plugging filed 6-9 19 60  
Application for plugging approved 6-9 19 60  
Plugging commenced 6-9 19 60  
Plugging completed 6-9 19 60  
Reason for abandonment of well or producing formation Dry Hole

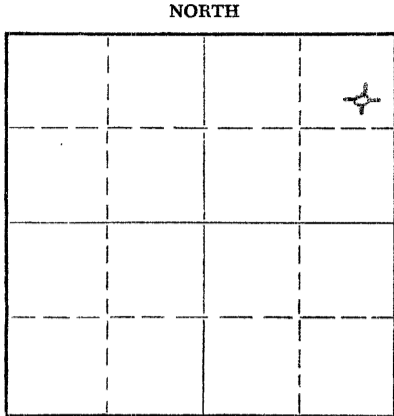

Locate well correctly on above Section Plat

If a producing well is abandoned, date of last production 19  
Was permission obtained from the Conservation Division or its agents before plugging was commenced? Yes

Name of Conservation Agent who supervised plugging of this well Eldon Petty  
Producing formation \_\_\_\_\_ Depth to top \_\_\_\_\_ Bottom \_\_\_\_\_ Total Depth of Well 3890 Feet  
Show depth and thickness of all water, oil and gas formations.

OIL, GAS OR WATER RECORDS

CASING RECORD

FORMATION	CONTENT	FROM	TO	SIZE	PUT IN	PULLED OUT
		0	273'	8 5/8"	273'	None

Describe in detail the manner in which the well was plugged, indicating where the mud fluid was placed and the method or methods used in introducing it into the hole. If cement or other plugs were used, state the character of same and depth placed, from \_\_\_\_\_ feet to \_\_\_\_\_ feet for each plug set.

- From 3890' to 601 1/2' - Heavy Rotary Mud
- From 601 1/2' to 600' - Wooden Plug
- From 600' to 535' - 20 sacks cement
- From 535' to 241 1/2' - Heavy Rotary Mud
- From 241 1/2' to 240' - Wooden Plug
- From 240' to 178' - 20 sacks cement
- From 178' to 41 1/2' - Heavy Rotary Mud
- From 41 1/2' to 40' - Wooden Plug
- From 40' to 6' - 10 sacks cement
- From 6' to Surface- Cellar

RECEIVED  
STATE CORPORATION COMMISSION  
JUN 20 1960  
6-20-1960  
CONSERVATION DIVISION  
Wichita, Kansas

(If additional description is necessary, use BACK of this sheet)

Name of Plugging Contractor \_\_\_\_\_  
Address \_\_\_\_\_

STATE OF KANSAS, COUNTY OF SEDGWICK, ss.  
William Herbert (employee of owner) or (owner or operator) of the above-described well, being first duly sworn on oath, says: That I have knowledge of the facts, statements, and matters herein contained and the log of the above-described well as filed and that the same are true and correct. So help me God.

(Signature) William Herbert  
R. R. #3, Box 144B, Wichita 20, Kansas  
(Address)

SUBSCRIBED AND SWORN TO before me this 16th day of June, 19 60

My commission expires March 4, 1962 Marion M. Herbert Notary Public.



DRILLER'S LOG

Company: Peel-Hardman Oil Operators  
 Farm: Lindenman "B" Well No. 2  
 Total Depth: 3890'  
 Comm.: 6-1-60 Comp.: 6-9-60  
 Contractor: Glenn W. Peel Drilling Co.  
 Casing: 8 5/8" @ 273' cem.

Location: SE NE NE  
 Sec. 6, Twp. 7S, Rge. 25W  
 County: Graham,  
 Kansas  
 Elevation:  
 Production: Dry

Figures Below Indicate Bottom of Formations

Surface Clay	0	30'
Sand		200
Sand & Clay		240
Shale		600
Shale & Shells		700
Shale		865
Shale & Shells		1585
Lime		1660
Shale		1800
Shale, Sand & Red Bed		1895
Shale & Red Bed		2160
Anhydrite		2200
Shale & Shells		2450
Shale & Lime		2675
Shale & Shells		2870
Shale & Lime		3080
Lime w/shale streaks		3170
Lime & Shale		3365
Lime		3890
Total Depth		3890

**RECEIVED**  
 STATE CORPORATION COMMISSION  
 JUN 20 1960  
 6-20-1960  
 CONSERVATION DIVISION  
 Wichita, Kansas

This is to certify that the above information is to the best of my knowledge true and correct.

GLENN W. PEEL DRILLING COMPANY

BY: Way Herber

SUBSCRIBED AND SWORN TO before me this 16th day of June, 1960.

My commission expires March 4, 1962.

Manar M. Herbert  
 Notary Public