

15-065-01038-00-00


STATE OF KANSAS
STATE CORPORATION COMMISSION

Form CP-4

WELL PLUGGING RECORD

Give All Information Completely
Make Required Affidavit
Mail or Deliver Report to:
Conservation Division
State Corporation Commission
211 No. Broadway
Wichita, Kansas

NORTH

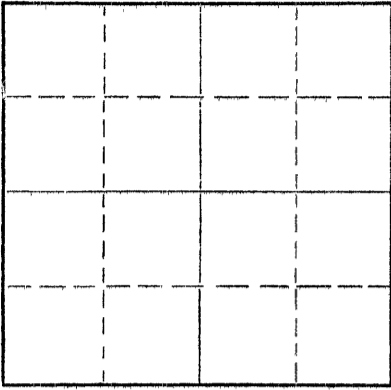

Locate well correctly on above
Section Plat

Graham County. Sec. 6 Twp. 7S Rge. 25 ~~W~~ (W)

Location as "NE/CNW/SW" or footage from lines NE NE SW

Lease Owner Peel-Hardman Oil Operators

Lease Name Shughart Well No. 1

Office Address R. R. No. 3 - Box 144 B - Wichita 20, Kansas

Character of Well (completed as Oil, Gas or Dry Hole) Dry hole

Date well completed 6-29 19 64

Application for plugging filed 6-29 19 64

Application for plugging approved 6-29 19 64

Plugging commenced 6-29 19 64

Plugging completed 6-29 19 64

Reason for abandonment of well or producing formation Dry hole

If a producing well is abandoned, date of last production 19

Was permission obtained from the Conservation Division or its agents before plugging was commenced? Yes

Name of Conservation Agent who supervised plugging of this well W. L. Nichols

Producing formation _____ Depth to top _____ Bottom _____ Total Depth of Well _____ Feet

Show depth and thickness of all water, oil and gas formations.

OIL, GAS OR WATER RECORDS

CASING RECORD

FORMATION	CONTENT	FROM	TO	SIZE	PUT IN	PULLED OUT

Describe in detail the manner in which the well was plugged, indicating where the mud fluid was placed and the method or methods used in introducing it into the hole. If cement or other plugs were used, state the character of same and depth placed, from _____ feet to _____ feet for each plug set.

3897 - 540 Heavy rotary mud
 540 HB plug, 20 sacks cement
 540 - 300 Heavy rotary mud
 300 HB plug, 20 sacks cement, 1/2 sack hulls
 300 - 40 Heavy rotary mud
 40 - GL HB plug, 10 sacks cement, 1/2 sack hulls

RECEIVED
STATE CORPORATION COMMISSION

JUL 17 1964

CONSERVATION DIVISION
Wichita, Kansas

7-17-64

(If additional description is necessary, use BACK of this sheet)

Name of Plugging Contractor Peel Brothers, Inc.

Address Box 359, Hoisington, Kansas

STATE OF Kansas, COUNTY OF Barton, ss.

Peel Brothers, Inc. (employee of owner) or (owner or operator) of the above-described

well, being first duly sworn on oath, says: That I have knowledge of the facts, statements, and matters herein contained and the log of the above-described well as filed and that the same are true and correct. So help me God. PEEL BROTHERS, INC.

(Signature) Jack Mattocks
W. E. "Jack" Mattocks
Drilling Superintendent

SUBSCRIBED AND SWORN TO before me this 30th day of June, 19 64

My commission expires June 21, 1966

Etzel S. Williamson
Notary Public.

15-065-01038-00-00

DRILLER'S LOG

Well Owner: Peel-Hardman Oil Operators
Farm Name: Shughart #1
Date Started: 6-23-64
Date Completed: 6-29-64
Total Depth: 3897
Casing: 8-5/8" set at 310' cemented

NE NE SW
Section 6-7S-25W
Graham County, Kansas

Contractor: Peel Brothers, Inc.

Figures below indicate bottoms of formations -

Clay	0	-	70
Shale and Shells			1070
Sand			1950
Sand and Shale			2080
Shale			2145
Anhydrite			2190
Lime, Shale, Chalk			3575
Lime and Shale			3580
Shale and Lime			3700
Lime			3897
Total Depth			3897

RECEIVED
STATE CORPORATION COMMISSION

JUL 7 1964
7-17-64
CONSERVATION DIVISION
Wichita, Kansas

This is to certify that the above information is to the best of our knowledge true and correct.

PEEL BROTHERS, INC.

Wendell G. Peel
Wendell G. Peel
President

SUBSCRIBED AND SWORN to before me this tenth day of July, 1964.

My commission expires: June 21, 1966

Ethel J. Williamson
Notary Public