

15-065-01310-00-00

WELL PLUGGING RECORD

Give All Information Completely  
Make Required Affidavit  
Mail or Deliver Report to:  
Conservation Division  
State Corporation Commission  
211 No. Broadway  
Wichita, Kansas

Graham County. Sec. 6 Twp. 7S Rge. XXX 25(W)

Location as "NE/CNW/SW" or footage from lines C N/2 N/2 NE/4

Lease Owner Glenn W. Peel Oil Operator

Lease Name Lindenman "B" Well No. 1

Office Address R. R. #3, Box 144B, Wichita, Kansas, 67208

Character of Well (completed as Oil, Gas or Dry Hole) Oil Well

Date well completed May 26, 1960

Application for plugging filed October 8, 1970

Application for plugging approved October 9, 1970

Plugging commenced December 1, 1970


Plugging completed December 4, 1970

Reason for abandonment of well or producing formation No longer a commercial

producer

If a producing well is abandoned, date of last production Oct. 4, 1970

Was permission obtained from the Conservation Division or its agents before plugging was commenced? Yes

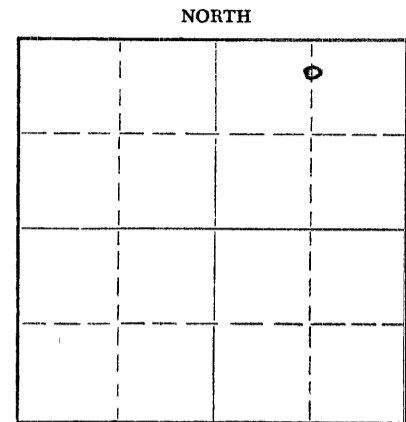

Locate well correctly on above Section Plat

Name of Conservation Agent who supervised plugging of this well W. L. Nichols

Producing formation Lansing-Kansas City Depth to top 3675 Bottom 3850 Total Depth of Well 3850 Feet

Show depth and thickness of all water, oil and gas formations.

OIL, GAS OR WATER RECORDS

CASING RECORD

FORMATION	CONTENT	FROM	TO	SIZE	PUT IN	PULLED OUT
				5 1/2"	3846'	1,207.83'
				8 5/8"	287'	None

Describe in detail the manner in which the well was plugged, indicating where the mud fluid was placed and the method or methods used in introducing it into the hole. If cement or other plugs were used, state the character of same and depth placed, from \_\_\_\_\_ feet to \_\_\_\_\_ feet for each plug set.

Made bottom hole plug back with sand to 3675', mixed and ran 5 sacks cement thru dump bailer. Squeezed hole with 5 sacks hulls - 8 sacks gel, followed with 100 sacks cement. Cement from 1300' to 975', followed with 17 sacks gel. Gel from 975' to 300', followed with 25 sacks cement. Cement from 300' to 225', followed with 5 sacks gel. Gel from 225' to 30'. Displaced with 10 sacks cement. Cement from 30' to base of cellar.

RECEIVED  
STATE CORPORATION COMMISSION  
DEC 10 1970  
CONSERVATION DIVISION  
Wichita, Kansas  
12-10-70

(If additional description is necessary, use BACK of this sheet)

Name of Plugging Contractor Southwest Casing Pulling Co.

Address Box 364, Great Bend, Kansas, 67530

STATE OF Kansas, COUNTY OF Sedgwick, ss.

William Herbert (employee of owner) ~~or (owner or operator)~~ of the above-described well, being first duly sworn on oath, says: That I have knowledge of the facts, statements, and matters herein contained and the log of the above-described well as filed and that the same are true and correct. So help me God.

(Signature) [Signature]

R. R. #3, Box 144B, Wichita, Kansas, 67208  
(Address)

SUBSCRIBED AND SWORN TO before me this 9th day of December, 19 70

My commission expires March 4, 1974 Marian M. Herbert Notary Public.

