

15-065-02629-00-00


STATE OF KANSAS  
STATE CORPORATION COMMISSION

Give All Information Completely  
Make Required Affidavit  
Mail or Deliver Report to:  
Conservation Division  
State Corporation Commission  
212 North Market, Insurance Bldg.  
Wichita, Kansas

WELL PLUGGING RECORD

Graham County. Sec. 6 Twp. 7S Rge. 25 (W)

Location as "NE/CNW/SW" or footage from lines NE NW NE  
Lease Owner Peel-Hardman Oil Operators  
Lease Name Lindenman Well No. 2  
Office Address R. R. #3, Box 144B, Wichita 20, Kansas  
Character of Well (completed as Oil, Gas or Dry Hole) Dry Hole  
Date well completed 5-31 19 60  
Application for plugging filed 5-31 19 60  
Application for plugging approved 5-31 19 60  
Plugging commenced 5-31 19 60  
Plugging completed 5-31 19 60  
Reason for abandonment of well or producing formation Dry Hole

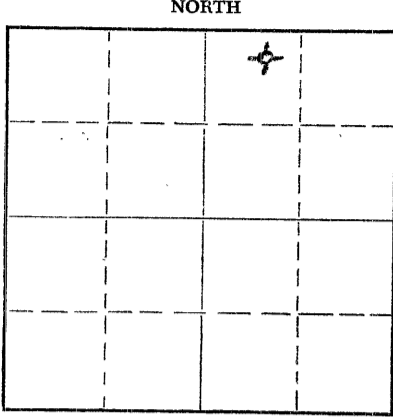

Locate well correctly on above Section Plat

If a producing well is abandoned, date of last production 19  
Was permission obtained from the Conservation Division or its agents before plugging was commenced? Yes

Name of Conservation Agent who supervised plugging of this well A. D. Fabricius  
Producing formation \_\_\_\_\_ Depth to top \_\_\_\_\_ Bottom \_\_\_\_\_ Total Depth of Well 3900 Feet  
Show depth and thickness of all water, oil and gas formations.

OIL, GAS OR WATER RECORDS

CASING RECORD

FORMATION	CONTENT	FROM	TO	SIZE	PUT IN	PULLED OUT
		0	295'	8 5/8"	295'	None

Describe in detail the manner in which the well was plugged, indicating where the mud fluid was placed and the method or methods used in introducing it into the hole. If cement or other plugs were used, state the character of same and depth placed, from \_\_\_\_\_ feet to \_\_\_\_\_ feet for each plug set.

- From 3900' to 401 1/2' - Heavy Rotary Mud
- " 401 1/2' to 400' - Wooden plug
- " 400' to 335' - 20 sacks cement
- " 335' to 291 1/2' - Heavy Rotary Mud
- " 291 1/2' to 290' - Wooden Plug
- " 290' to 228' - 20 sacks cement
- " 228' to 41 1/2' - Heavy Rotary Mud
- " 41 1/2' to 40' - Wooden plug
- " 40' to 6' - 10 sacks cement & 1/2 sack Hulls
- " 6' to Surface - Cellar

RECEIVED  
STATE CORPORATION COMMISSION

JUN 20 1960

CONSERVATION DIVISION  
Wichita, Kansas

6-20-60

(If additional description is necessary, use BACK of this sheet)

Name of Plugging Contractor \_\_\_\_\_  
Address \_\_\_\_\_

STATE OF KANSAS, COUNTY OF SEDGWICK, ss.  
William Herbert (employee of owner) or (owner/proprietor) of the above-described well, being first duly sworn on oath, says: That I have knowledge of the facts, statements, and matters herein contained and the log of the above-described well as filed and that the same are true and correct. So help me God.

(Signature) *William Herbert*  
R. R. #3, Box 144 B, Wichita 20, Kansas (Address)

SUBSCRIBED AND SWORN TO before me this 16th day of June, 19 60

My commission expires March 4, 1962 *Marvin M. Herbert* Notary Public.



15-069-02629-00-00

DRILLER'S LOG

Company: Peel-Hardman Oil Operators

Location: NE NW NE  
Sec. 6, Twp. 7S, Rge. 25W

Farm: Lindenman Well No. 2

County: Graham,  
Kansas

Total Depth: 3900'

Comm.: 5-22-60 Comp.: 5-31-60  
Contractor: Glenn W. Peel Drilling Co.

Elevation:  
Production: Dry

Casing: 8 5/8" @ 295' cem.

FIGURES BELOW INDICATE BOTTOM OF FORMATIONS

Surface Clay	0	35'
Sand		210
Sand & Clay		260
Shale		620
Shale & Shells		720
Shale		945
Shale & Shells		1832
Shale w/sand streaks		1880
Shale & Red Bed		1925
Red Bed		2177
Anhydrite		2210
Shale		2425
Shale & Lime		3265
Lime		3900
Total Depth		3900

RECEIVED  
STATE CORPORATION COMMISSION

JUN 20 1960

CONSERVATION DIVISION  
Wichita, Kansas

6-20-60

This is to certify that the above information is to the best of my knowledge true and correct.

GLENN W. PEEL DRILLING COMPANY

BY: Wm Herbert

SUBSCRIBED AND SWORN TO before me this 16th day of June, 1960.

My commission expires March 4, 1962.

Manan M. Herbert  
Notary Public