

15-065-00072-00-00


STATE OF KANSAS
STATE CORPORATION COMMISSION

WELL PLUGGING RECORD

Give All Information Completely
Make Required Affidavit
Mail or Deliver Report to:
Conservation Division
State Corporation Commission
800 Bittling Building
Wichita, Kansas

OR
FORMATION PLUGGING RECORD Strike out upper line when reporting plugging of formations.

Graham County. Sec. 15 Twp. 7 Rge. 25 (W)
Location as "NE 1/4 NW 1/4 SW 1/4" or footage from lines. SW SW SE
Lease Owner. The Derby Oil Company
Lease Name. Toll Well No. 1
Office Address. 420 West Douglas, Wichita, Kansas.
Character of Well (completed as Oil, Gas or Dry Hole). Dry Hole
Date well completed. Dec. 14, 1948
Application for plugging filed. Jan. 12, 1949
Application for plugging approved. Jan. 13, 1949
Plugging commenced. March 10, 1949
Plugging completed. March 19, 1949
Reason for abandonment of well or producing formation. Dry hole

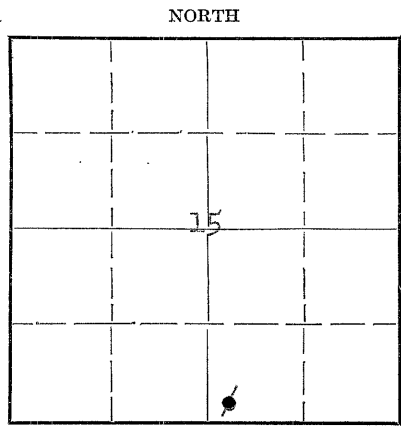

Locate well correctly on above Section Plat

If a producing well is abandoned, date of last production. 19
Was permission obtained from the Conservation Division or its agents before plugging was commenced? Yes

Name of Conservation Agent who supervised plugging of this well. Mr. Eldon Petty
Producing formation. - - - Depth to top. Bottom. Total Depth of Well. 4251 Feet
Show depth and thickness of all water, oil and gas formations.

OIL, GAS OR WATER RECORDS

CASING RECORD

Formation	Content	From	To	Size	Put In	Pulled Out
				8 5/8"	147	None
				5 1/2"	4246	3340

Describe in detail the manner in which the well was plugged, indicating where the mud fluid was placed and the method or methods used in introducing it into the hole. If cement or other plugs were used, state the character of same and depth placed, from feet to feet for each plug set.

Cement 4251 - 4203
Heavy mud 4203 - 165
Cement 165 - 90
Heavy mud 90 - 21
Cement 21 - 6
Cellar 6 - 0

RECEIVED
APR 30 1949
STATE CORPORATION COMMISSION
KANSAS
4-30-49

(If additional description is necessary, use BACK of this sheet)

Correspondence regarding this well should be addressed to The Derby Oil Company
Address. Box 1030, Wichita, Kansas.

STATE OF Kansas, COUNTY OF Sedgwick, ss.

J. R. Bratcher (employee of owner or owner or operator) of the above-described well, being first duly sworn on oath, says: That I have knowledge of the facts, statements, and matters herein contained and the log of the above-described well as filed and that the same are true and correct. So help me God.

(Signature) J. R. Bratcher
Derby Oil Company, Wichita, Kansas.
(Address)

SUBSCRIBED AND SWORN to before me this 29th day of April, 1949

Ruth L. Knouse
Ruth L. Knouse, Notary Public.

My commission expires June 11, 1952.

22-2625 2-18-15M

PLUGGING
FILE SEC 15 T 7 R 25 W
BOOK PAGE 79 LINE 88

15-009-00072-00-00

DRILLER'S LOG

Company: The Derby Oil Company
Glenn W. Peel Oil Producer
R. C. McCormick

Sec. 15 Twp. 7S Rgs. 25W
SW SW SW

County: Graham
Kansas

Form: Toll Well No. 1

Total Depth: 4250' (Notary)
Comm.: 11-5-48 Comp.: 12-1-48
Contractor: Glenn Peel Drilling Co., Inc.
Casing:
6 5/8" 147' con.
5 1/2" 4246' con.

Elevation:
Production:

Figures below indicate bottom of formations

Surface Clay and Sand	0	79
Sand and Shale		108
Sand, Shale and Shells		163
Sand		210
Clay		260
Shale and Shells		1015
Sand and Shale Streaks		1200
Shale and Sand Streaks		1370
Shale and Shells		1675
Shale, Shells and Red Bed		2125
Shale and Shells		2180
Anhydrite		2230
Shale and Shells		2795
Lime		2850
Shale and Lime		3050
Shale and Shells		3090
Lime and Shale		3140
Shale, Lime and Iron Streaks		3190
Lime, Shale and Iron		3255
Lime and Shale		3645
Lime		4080
Lime and Shale		4180
Conglomerate		4200
Cherty Conglomerate		4215
Chert and Lime		4230
Cherty Conglomerate		4237
Lime		4250
Total Depth		4250

4-30-1949

This is to certify that the above information is, to the best of our knowledge, true and correct.

GLENN PEEL DRILLING COMPANY, INC.

BY: Glenn W. Peel

SUBSCRIBED AND SWORN to before me this 1st day of December, 1948.

Notary Public

My commission expires June 4, 1951.

PLUGGING
FILE SEC 15 T 7 R 26 W
BOOK PAGE 79 LINE 28