


15-065-01035-00-00

Give All Information Completely
Make Required Affidavit
Mail or Deliver Report to:
Conservation Division
State Corporation Commission
211 No. Broadway
Wichita, Kansas

WELL PLUGGING RECORD

NORTH

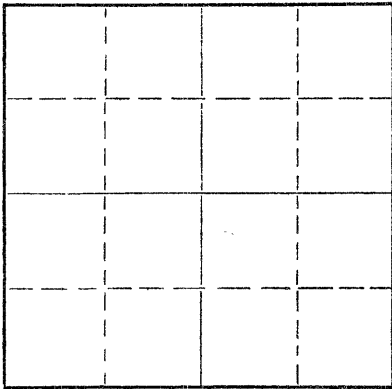

Locate well correctly on above
Section Plat

Graham County, Sec. 10 Twp. 7S Rge. 23W (E) (W)

Location as "NE/CNW/SW" or footage from lines. C SE SW
Lease Owner Imperial Oil Company
Lease Name SCOTT Well No. 1
Office Address 780 Fourth National Bldg., Wichita, Kansas
Character of Well (completed as Oil, Gas or Dry Hole) Dry hole
Date well completed 10/18/62 19
Application for plugging filed 10/18/62 19
Application for plugging approved 10/18/62 19
Plugging commenced 10/18/62 19
Plugging completed 10/18/62 19

Reason for abandonment of well or producing formation
No commercial quantities of oil found
If a producing well is abandoned, date of last production -- 19
Was permission obtained from the Conservation Division or its agents before plugging was commenced? Yes

Name of Conservation Agent who supervised plugging of this well Eldon Petty, Hays, Ks.
Producing formation _____ Depth to top _____ Bottom _____ Total Depth of Well 3860 Feet
Show depth and thickness of all water, oil and gas formations.

OIL, GAS OR WATER RECORDS

CASING RECORD

FORMATION	CONTENT	FROM	TO	SIZE	PUT IN	PULLED OUT
	Surface casing	8-5/8"	at 188'	not pulled		

Describe in detail the manner in which the well was plugged, indicating where the mud fluid was placed and the method or methods used in introducing it into the hole. If cement or other plugs were used, state the character of same and depth placed, from _____ feet to _____ feet for each plug set.

Set first plug at 500' with 20 sacks cement
Set second plug at 180' with 15 sacks cement
Set top plug at 40' with 10 sacks cement

RECEIVED
STATE CORPORATION COMMISSION

OCT 20 1962

CONSERVATION DIVISION
Wichita

10-29-62

(If additional description is necessary, use BACK of this sheet)

Name of Plugging Contractor Imperial Oil of Kansas, Inc.
Address Box 97, WaKeeney, Kansas

STATE OF Kansas, COUNTY OF Sedgwick, ss.
John Lehman (employee of owner) or (owner) of the above-described well, being first duly sworn on oath, says: That I have knowledge of the facts, statements, and matters herein contained and the log of the above-described well as filed and that the same are true and correct. So help me God.

(Signature) John Lehman
780 Fourth Natl. Bldg., Wichita, Kansas
(Address)

SUBSCRIBED AND SWORN TO before me this 25th day of October 1962

My commission expires July 5, 1966
Bette J. Silcott Notary Public.



15-069-01035-00-00

DRILLER'S LOG

RECEIVED
STATE CORPORATION COMMISSION

OCT 29 1962

Imperial Oil Company
780 Fourth National Building
Wichita, Kansas

CONSERVATION DIVISION
Wichita, Kansas

10-20-62

SCOTT NO. 1
C SE SW Sec. 10-7S-23W
Graham County, Kansas

Total Depth: 3860'

Elevation: 2375 K.B.
Production: dry

Commenced: 10/11/62 Completed 10/18/62

Contractor: Imperial Oil of Kansas, Inc.
Wichita 2, Kansas

Casing Record: Set 8-5/8" surface pipe at 188' with 150 sacks cement.

Figures indicate bottom of formation:

Sand & Shale	188'	Anhydrite	2067 (+308)
Shale	800'	Heebner	3618 (-1243)
Sand & Shale	1620'	Toronto	3644 (-1269)
Dakota Sand	1820'	Lansing	3659 (-1284)
Shale & Red Bed	2067'	B/Kansas City	3853 (-1478)
Anhydrite	2102'	Rotary Total Depth	3860 (-1485)
Shale & Shells	2365'		
Shale & Lime	3538'		
Lime	3602'		
Lime & Shale	3670'		
Lime	3860'		

We hereby certify this to be a correct and accurate log of the above described well, as shown on the daily drilling reports.

Imperial Oil Company

Raymond R. Dombaugh
Raymond R. Dombaugh

Subscribed and sworn to before me this 25th day of October, 1962

My commission expires:

July 5, 1966

Bette J. Silcott
Bette J. Silcott, Notary Public