


STATE OF KANSAS
STATE CORPORATION COMMISSION

WELL PLUGGING RECORD

Give All Information Completely
Make Required Affidavit
Mail or Deliver Report to
Conservation Division
State Corporation Comm.
245 North Water
Wichita, KS 67202

Graham County, Sec. 30 Twp. 7S Rge. 25 &W
Location as "NE/CNW 1/4 SW 1/4" or footage from lines
1650' FEL x 1320' FSL
Lease Owner Antares Oil Corporation
Lease Name Bell Well No. 10D-30
Office Address 1801 California St., #200, Denver, Co. 80202
Character of Well (Completed as Oil, Gas or Dry Hole) Oil

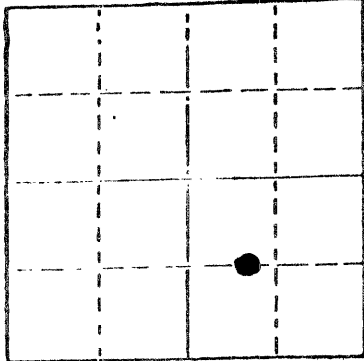

Locate well correctly on above
Section Plot

Date Well completed 7/12 1982
Application for plugging filed N/A 19
Application for plugging approved 10/10 1984
Plugging commenced 4/4 1985
Plugging completed 4/4 1984
Reason for abandonment of well or producing formation
Non-Commercial

If a producing well is abandoned, date of last production
August 193

Was permission obtained from the Conservation Division or
its agents before plugging was commenced? Yes

Name of Conservation Agent who supervised plugging of this well Carl Goodrow
Producing formation Lansing-Kansas City Depth to top 3902 Bottom 3956 Total Depth of Well 4050
Show depth and thickness of all water, oil and gas formations.

OIL, GAS OR WATER RECORDS

CASING RECORD

FORMATION	CONTENT	FROM	TO	SIZE	PUT IN	PULLED OUT
Lansing-Kansas City	Oil	3902	3956	8-5/8"	267'	None
				4-1/2"	4049'	None

Describe in detail the manner in which the well was plugged, indicating where the mud fluid
was placed and the method or methods used in introducing it into the hold. If cement or other
plugs were used, state the character of same and depth placed, from feet to
feet for each plug set.

No pipe recovered. Pumped down 4-1/2" - 4 sx. hulls, 100 sx. cement,
15 sx. gel, 100 sx. cement. Max. pressure 1000#, shut-in 500#. Pumped
down backside 1 sx. hulls, 5 sx. gel, 50 sx. cement. Max. pressure
500#, shut-in 200#

(If additional description is necessary, use BACK of this sheet)

Name of Plugging Contractor Allied Cement Co., Plainview, Kansas

STATE OF Colorado COUNTY OF Denver, ss.
David A. Norby (employee of owner) or (owner/owner's representative)

of the above-described well, being first duly sworn on oath, says: That I have knowledge of
the facts, statements, and matters herein contained and the log of the above-described well
as filed and that the same are true and correct. So help me God.

(Signature) *David A. Norby*
1801 California St., #200, Denver, Co. 80202
(Address)

SUBSCRIBED AND SWORN TO before me this 4th day of October, 1985

My commission expires January 31, 1987

Sonja M. Reilly
Notary Public.

RECEIVED
STATE CORPORATION COMMISSION
OCT 7 1985
OCT 7, 1985
CONSERVATION DIVISION
Wichita, Kansas