

CARD MUST BE TYPED

State of Kansas

CARD MUST BE SIGNED

NOTICE OF INTENTION TO DRILL

(see rules on reverse side)

Starting Date 3 29 86
 month day year

API Number 15— 121-26,751-00-00

OPERATOR: License # 6168
Name Lester Scheuneman
Address 701 Main
City/State/Zip Osawatomie, Kansas 66064
Contact Person Lester Scheuneman
Phone 913-755-2342

app. NE NE SW Sec. 14 Twp. 17 S, Rg. 22 East
 2195 — West
 3040 Ft. from South Line of Section
 Ft. from East Line of Section

(Note: Locate well on Section Plat on reverse side)

CONTRACTOR: License #
Name unknown
City/State

Nearest lease or unit boundary line 400 feet
County Miami
Lease Name Clinton Well # 4

Well Drilled For: Well Class: Type Equipment:
 Oil — SWD — Infield — Mud Rotary
— Gas — Inj — Pool Ext. Air Rotary
— OWWO — Expl Wildcat — Cable

Ground surface elevation feet MSL
Domestic well within 330 feet: — yes no
Municipal well within one mile: — yes no

If OWWO: old well info as follows:

Operator
Well Name
Comp Date Old Total Depth

Depth to bottom of fresh water 35
Depth to bottom of usable water 200
Surface pipe by Alternate: 1 2
Surface pipe planned to be set 20

I certify that well will comply with K.S.A. 55-101, et seq., plus eventually plugging hole to KCC specifications.

Date ... 3-20-86 ... Signature of Operator or Agent *Nana Elman* ... Title ... as agent

For KCC Use:

Conductor Pipe Required feet; Minimum Surface Pipe Required feet per Alt. *20*


This Authorization Expires *9-20-86* ... Approved By *3-20-86* *R. ECH/10/11*

Must be filed with the K.C.C. five (5) days prior to commencing well
 This card void if drilling not started within six (6) months of date received by K.C.C.

Important procedures to follow:

1. Notify District office before setting surface casing.
2. Set surface casing by circulating cement to the top.
3. File completion forms ACO-1 with K.C.C. within 90 days of well completion, following instructions on ACO-1, side 1, and including copies of wireline logs.
4. Notify District office 48 hours prior to old well workover or re-entry.
5. Prior to filing Intent, prepare a proposed plugging plan in case well is D & A, then obtain approval of plan when calling district office prior to setting surface pipe.
6. Submit plugging report (CP-4) to K. C. C. after plugging is completed.
7. Obtain an approved injection docket number before disposing of salt water.
8. Notify K.C.C. within 10 days when injection commences or terminates.

A Regular Section of Land
1 Mile = 5,280 Ft.

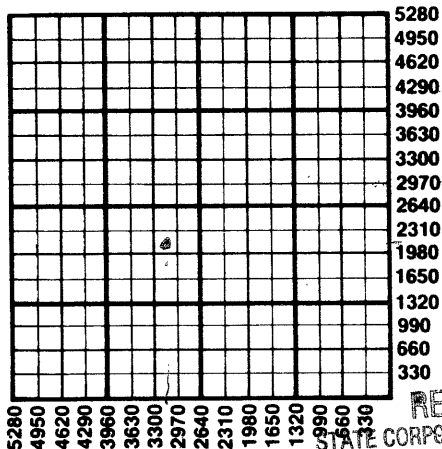

RECEIVED

STATE CORPORATION COMMISSION

MAR 20 1980

CONSERVATION DIVISION
 Wichita, Kansas

an alternate 2 completion, cement in the production pipe from below any usable water to surface within 120 days of spud date.

State Corporation Commission of Kansas
 Conservation Division
 200 Colorado Derby Building
 Wichita, Kansas 67202
 (316) 263-3238