


STATE OF KANSAS
STATE CORPORATION COMMISSION

Give All Information Completely
Make Required Affidavit
Mail or Deliver Report to:
Conservation Division
State Corporation Commission
211 No. Broadway
Wichita, Kansas

15-179-30165-00-00

WELL PLUGGING RECORD

NORTH

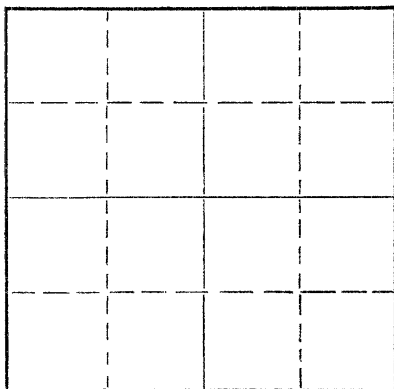

Locate well correctly on above
Section Plat

Sheridan County. Sec. 13 Twp. 7S Rge. (E) 30 (W)
Location as "NE/CNW $\frac{1}{2}$ SW $\frac{1}{2}$ " or footage from lines SE SE NW
Lease Owner John O. Farmer, Inc.
Lease Name McBride Well No. 1
Office Address Russell, Kansas
Character of Well (completed as Oil, Gas or Dry Hole) Dry
Date well completed 6/5 1958
Application for plugging filed 6/5 1958
Application for plugging approved 6/5 1958
Plugging commenced 6/5 1958
Plugging completed 6/5 1958
Reason for abandonment of well or producing formation Dry

If a producing well is abandoned, date of last production 19
Was permission obtained from the Conservation Division or its agents before plugging was commenced? yes

Name of Conservation Agent who supervised plugging of this well Mr. Fabricius, Hill City, Kansas
Producing formation _____ Depth to top _____ Bottom _____ Total Depth of Well 4215 Feet
Show depth and thickness of all water, oil and gas formations.

OIL, GAS OR WATER RECORDS

CASING RECORD

FORMATION	CONTENT	FROM	TO	SIZE	PUT IN	PULLED OUT
				8-5/8	274	None

Describe in detail the manner in which the well was plugged, indicating where the mud fluid was placed and the method or methods used in introducing it into the hole. If cement or other plugs were used, state the character of same and depth placed, from _____ feet to _____ feet for each plug set.


First plug set at 600 feet with 25 sacks cement

Second plug set at 270 feet with 15 sacks cement

Last plug set at 40 feet with 10 sacks cement

06-11-1958

Name of Plugging Contractor John O. Farmer, Inc.
Address Russell, Kansas

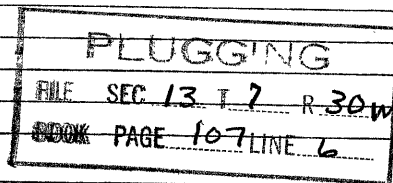

STATE OF Kansas, COUNTY OF Russell, ss.
JOHN O. FARMER (employer of owner) or (owner or operator) of the above-described well, being first duly sworn on oath, says: That I have knowledge of the facts, statements, and matters herein contained and the log of the above-described well as filed and that the same are true and correct. So help me God.

(Signature)

John O. Farmer
Russell, Kansas
(Address)

SUBSCRIBED AND SWORN TO before me this 9th day of June, 19 58

My commission expires October 11, 1958

Lucille Kennedy
Lucille Kennedy
Notary Public.



OPERATOR JOHN O. FARMER, INC.


15-179-30165-00-00

ADDRESS Russell, Kansas

FORMATION RECORD

Give detailed description and thickness of all formations drilled through, contents of sand, whether dry, water, oil or gas.

WELL NO. 1 COUNTY Sheridan SEC. 13 TWP. 7S RGE. 30W

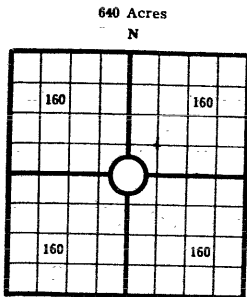

Locate well correctly

COUNTY Sheridan SEC. 13 TWP. 7 RGE. 30W
 COMPANY OPERATING John O. Farmer, Inc.
 OFFICE ADDRESS Russell, Kansas
 FARM NAME McBride WELL NO. 1
 DRILLING STARTED 5/26, 1958 DRILLING FINISHED 6/5, 1958
 DATE OF FIRST PRODUCTION _____ COMPLETED _____
 WELL LOCATED SE 1/4 SE 1/4 NW 1/4 North of South
 Line and _____ ft. East of West Line of Quarter Section
 Elevation (Relative to sea level) DERRICK FLOOR 2893 GROUND 2890
 CHARACTER OF WELL (Oil, gas or dryhole) dry

OIL OR GAS SANDS OR ZONES

Name	From	To	Name	From	To
1			4		
2			5		
3			6		

Perforating Record If Any

Shot Record

Formation	From	To	No. of Shots	Formation	From	To	Size of Shot

CASING RECORD

Amount Set						Amount Pulled		Packer Record	
Size	Wt.	Thds.	Make	Ft.	In.	Size	Length	Depth Set	Make
8-5/8				274					

Liner Record: Amount _____ Kind _____ Top _____ Bottom _____

CEMENTING AND MUDDING

Size	Amount Set		Sacks Cement	Chemical		Method of Cementing	Amount	Mudding Method	Results (See Note)
	Ft.	In.		Gal.	Make				
8-5/8	274		150						

Note: What method was used to protect sands if outer strings were pulled? _____

NOTE: Were bottom hole plugs used? _____ If so, state kind, depth set and results obtained. _____

TOOLS USED

Rotary Tools were used from _____ feet to _____ Cable tools were used from _____ feet to _____

_____ feet, and from _____ feet to _____ feet, and from _____ feet to _____

Type Rig _____

INITIAL PRODUCTION TEST

Describe initial test: whether by flow through tubing or casing or by pumping _____

Amount of Oil Production _____ bbls. Size of choke, if any _____ Length of test _____ Water

Production _____ bbls. Gravity of oil _____ Type of Pump if pump is used, describe _____

Formation	Top	Bottom	Formation	Top	Bottom
Shale & sand	0	165			
Shale	270	870			
Shale & shells	870	1750			
Shale & sand	1750	1990			
Shale & shells	1990	2559			
Anhydrite	2559	2599			
Shale & redbed	2599	2650			
Shale & shells	2650	2850			
Shale & lime	2850	3290			
Lime & shale	3290	3520			
Shale & lime	3520	3750			
Lime & shale	3750	3985			
Lime	3985	4015			
Lime & shale	4015	4095			
Lime	4095	4135			
Lime & shale	4135	4215			
T.D.		4215			

PLUGGING
 FILE SEC. 13, T. 7, R. 30W
 BOOK - PAGE 107 LINE 6

6/11/58

SAMPLE TOPS:

Elevation:	RB	
		2895
Topeka		3735
Heebner		3938
Toronto		3963
Lansing-KC		3978
B/Kansas City		4205
R.T.D.		4215

I, the undersigned, being first duly sworn upon oath, state that this well record is true, correct and complete according to the records of this office and to the best of my knowledge and belief.

John O. Farmer
 Name and title of representative of company

Subscribed and sworn to before me this 9th day of June, 19 58

My Commission expires 10/11/58

Shirley Kennedy
 Notary Public